


REPOLY PTY LTD

MOSS VALE PLASTICS RECYCLING AND REPROCESSING FACILITY

12673448

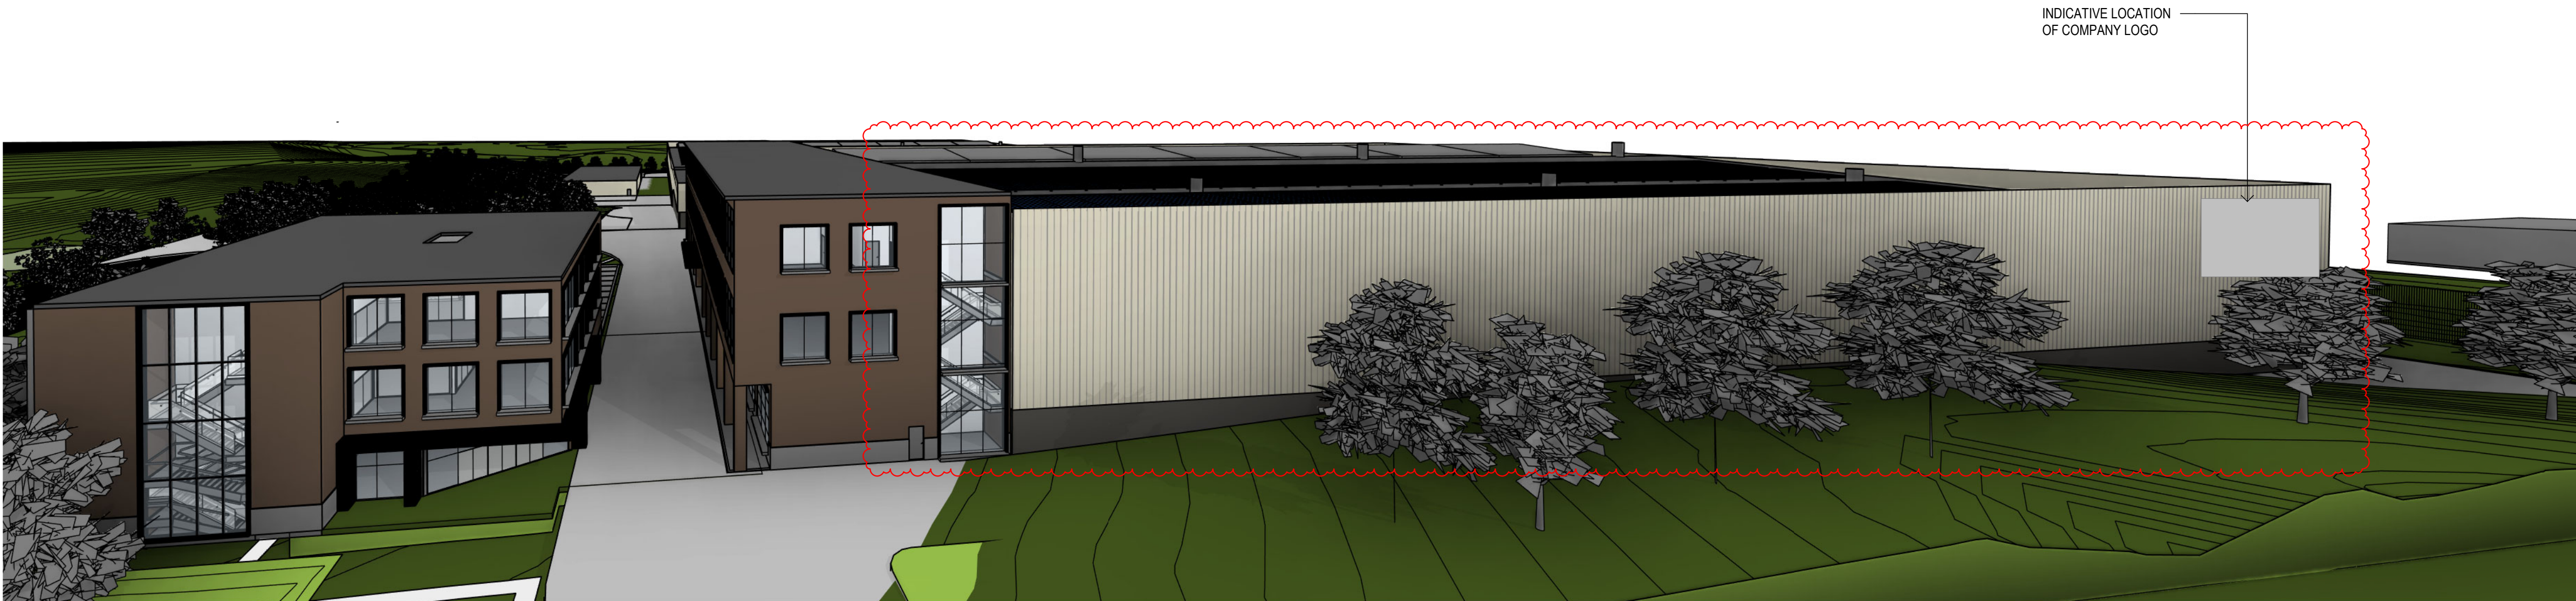

INDICATIVE LOCATION
OF COMPANY LOGO

DRAWING INDEX

SHEET NO.	SHEET NAME
00	COVER SHEET
1	PRELIMINARY STORMWATER ARRANGEMENT
01	SITE PLAN
02	SHADOW ANALYSIS
20	ADMIN BUILDING - GROUND PLAN
21	ADMIN BUILDING - LEVEL 1 PLAN
22	ADMIN BUILDING - LEVEL 2 PLAN
23	ADMIN BUILDING - ELEVATIONS
30	MULTI-USE BUILDING - GROUND PLAN
31	MULTI-USE BUILDING - LEVEL 1 PLAN
32	MULTI-USE BUILDING - LEVEL 2 PLAN
33	MULTI-USE BUILDING - ELEVATIONS
40	BUILDING 1 - MAIN PROCESSING BUILDING - GROUND PLAN
41	BUILDING 1 - MAIN PROCESSING BUILDING - ELEVATIONS
50	BUILDING 2 - SECONDARY PROCESSING BUILDING - GROUND PLAN
51	BUILDING 2 - SECONDARY PROCESSING BUILDING - ELEVATIONS
60	WASTE WATER TREATMENT PLANT - GROUND PLAN
61	WASTE WATER TREATMENT PLANT - ELEVATIONS
73	SITE SECTIONS
A1	PRELIMINARY STORMWATER ARRANGEMENT

G	ISSUED FOR MOSS VALE APPEAL SUPPORT	L.C.	D.G.	17.07.25
F	ISSUED FOR MOSS VALE APPEAL SUPPORT	L.C.	D.G.	04.07.25
E	ISSUED FOR EIS	L.C.	D.G.	20.04.24
D	ISSUED FOR EIS	L.C.	D.G.	19.04.24
C	ISSUED FOR EIS	L.C.	D.G.	14.03.24
B	ISSUED FOR EIS	L.C.	D.G.	01.02.24
Rev	Description	Checked	Approved	Date
Drafting Check	S.HO	Reg Architect	L.COLLINS	
Design Check	L.COLLINS	State and Reg No.	NSW 11483	



Level 15, 133 Castlereagh Street
Sydney NSW 2000 Australia
T 61 2 9239 7100 F 61 2 9239 7199
E sydney@ghd.com W www.ghd.com/design
Conditions of Use: This document may only be used by GHD Design's client (and any other person who GHD Design has agreed can use this document) for the purpose for which it was prepared and must not be used by any other person or for any other purpose.



Nominated Architects:
Chris Asenki NSW 6843
Daphne Chong NSW 9410
Lae Collins NSW 11483
Annie Tsang NSW 8408

Project No.
12673448

Client	REPOLY PTY LTD
Project	MOSS VALE PLASTICS RECYCLING AND REPROCESSING FACILITY
Status	FOR INFORMATION ONLY

Drawing Title
COVER SHEET



Drawing No.
12673448-00

Size
A1

Rev
G



Rev	Description	Checked	Approved	Date
G	ISSUED FOR MOSS VALE APPEAL SUPPORT	LC	D.G	17.07.25
F	ISSUED FOR MOSS VALE APPEAL SUPPORT	LC	D.G	04.07.25
E	ISSUED FOR EIS	LC	D.G	20.04.24
D	ISSUED FOR EIS	LC	D.G	19.04.24
C	ISSUED FOR EIS	LC	D.G	14.03.24
B	ISSUED FOR EIS	LC	D.G	01.02.24
Reg Architect	L.COLLINS	State and Reg No.	NSW 11483	
Drafting Check	S.HO	Design Check	L.COLLINS	

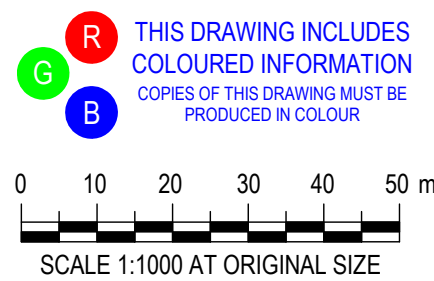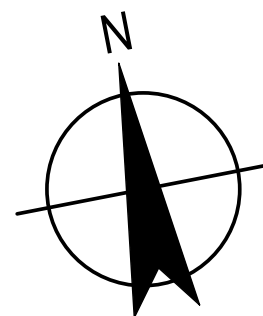

Level 15, 133 Castlereagh Street
Sydney NSW 2000 Australia
T 61 2 9239 7100 F 61 2 9239 7199
E sydney@ghd.com W www.ghd.com/design
Conditions of Use: This document may only be used by GHD Design's client (and any other person who GHD Design has agreed can use this document) for the purpose for which it was prepared and must not be used by any other person or for any other purpose.



Nominated Architects:
Chris Asovski NSW 6843
Daphne Chong NSW 9410
Lee Collins NSW 11483
Annie Tsang NSW 8408
Project No.
12673448


Client	REPOLY PTY LTD
Project	MOSS VALE PLASTICS RECYCLING AND REPROCESSING FACILITY
Status	FOR INFORMATION ONLY

Drawing Title
SITE PLAN


Drawing No.
12673448-01

Size
A1


Rev
G

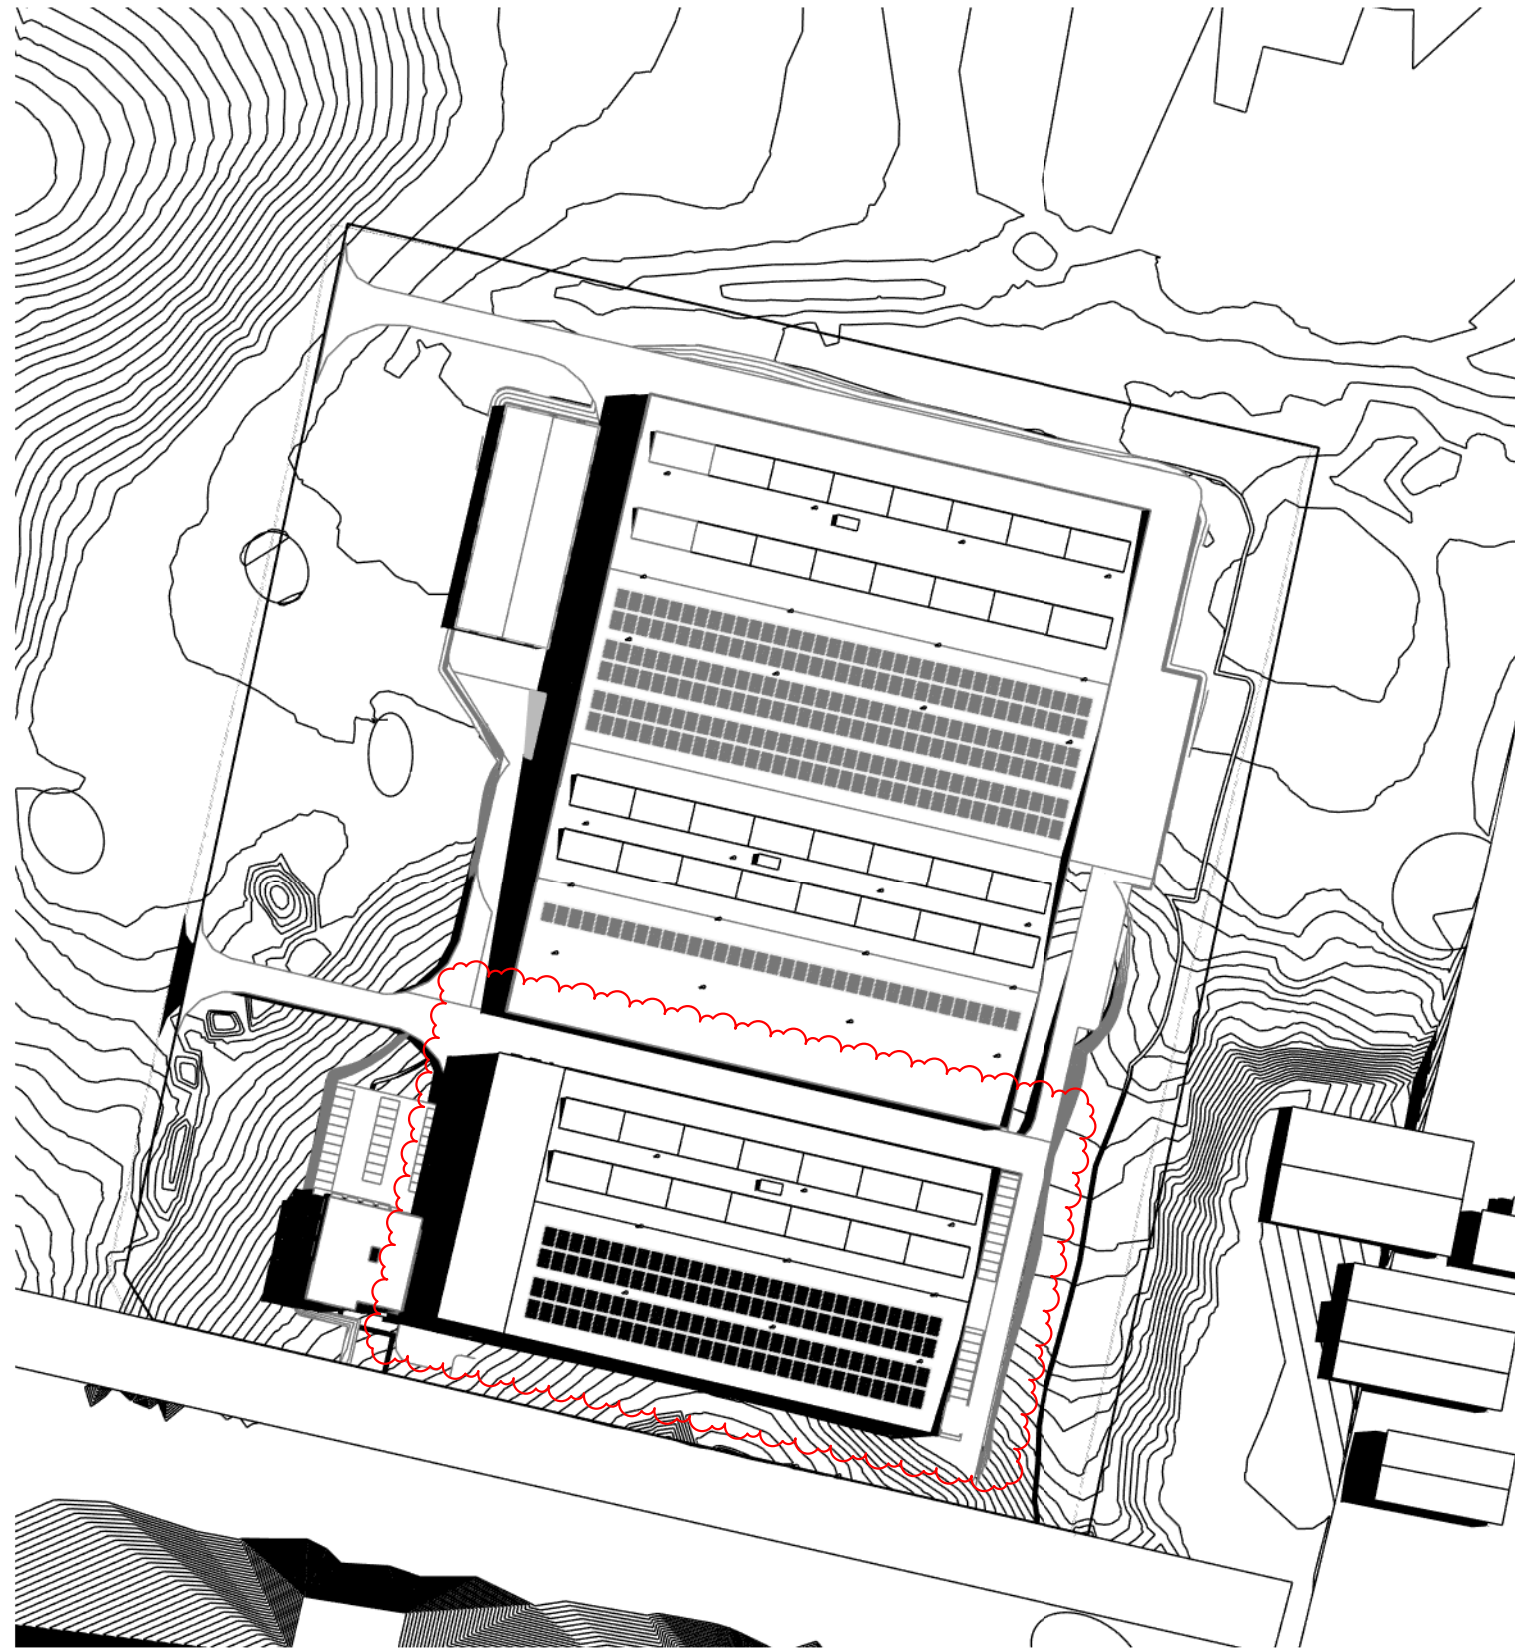


SUMMER SOLSTICE - 9AM

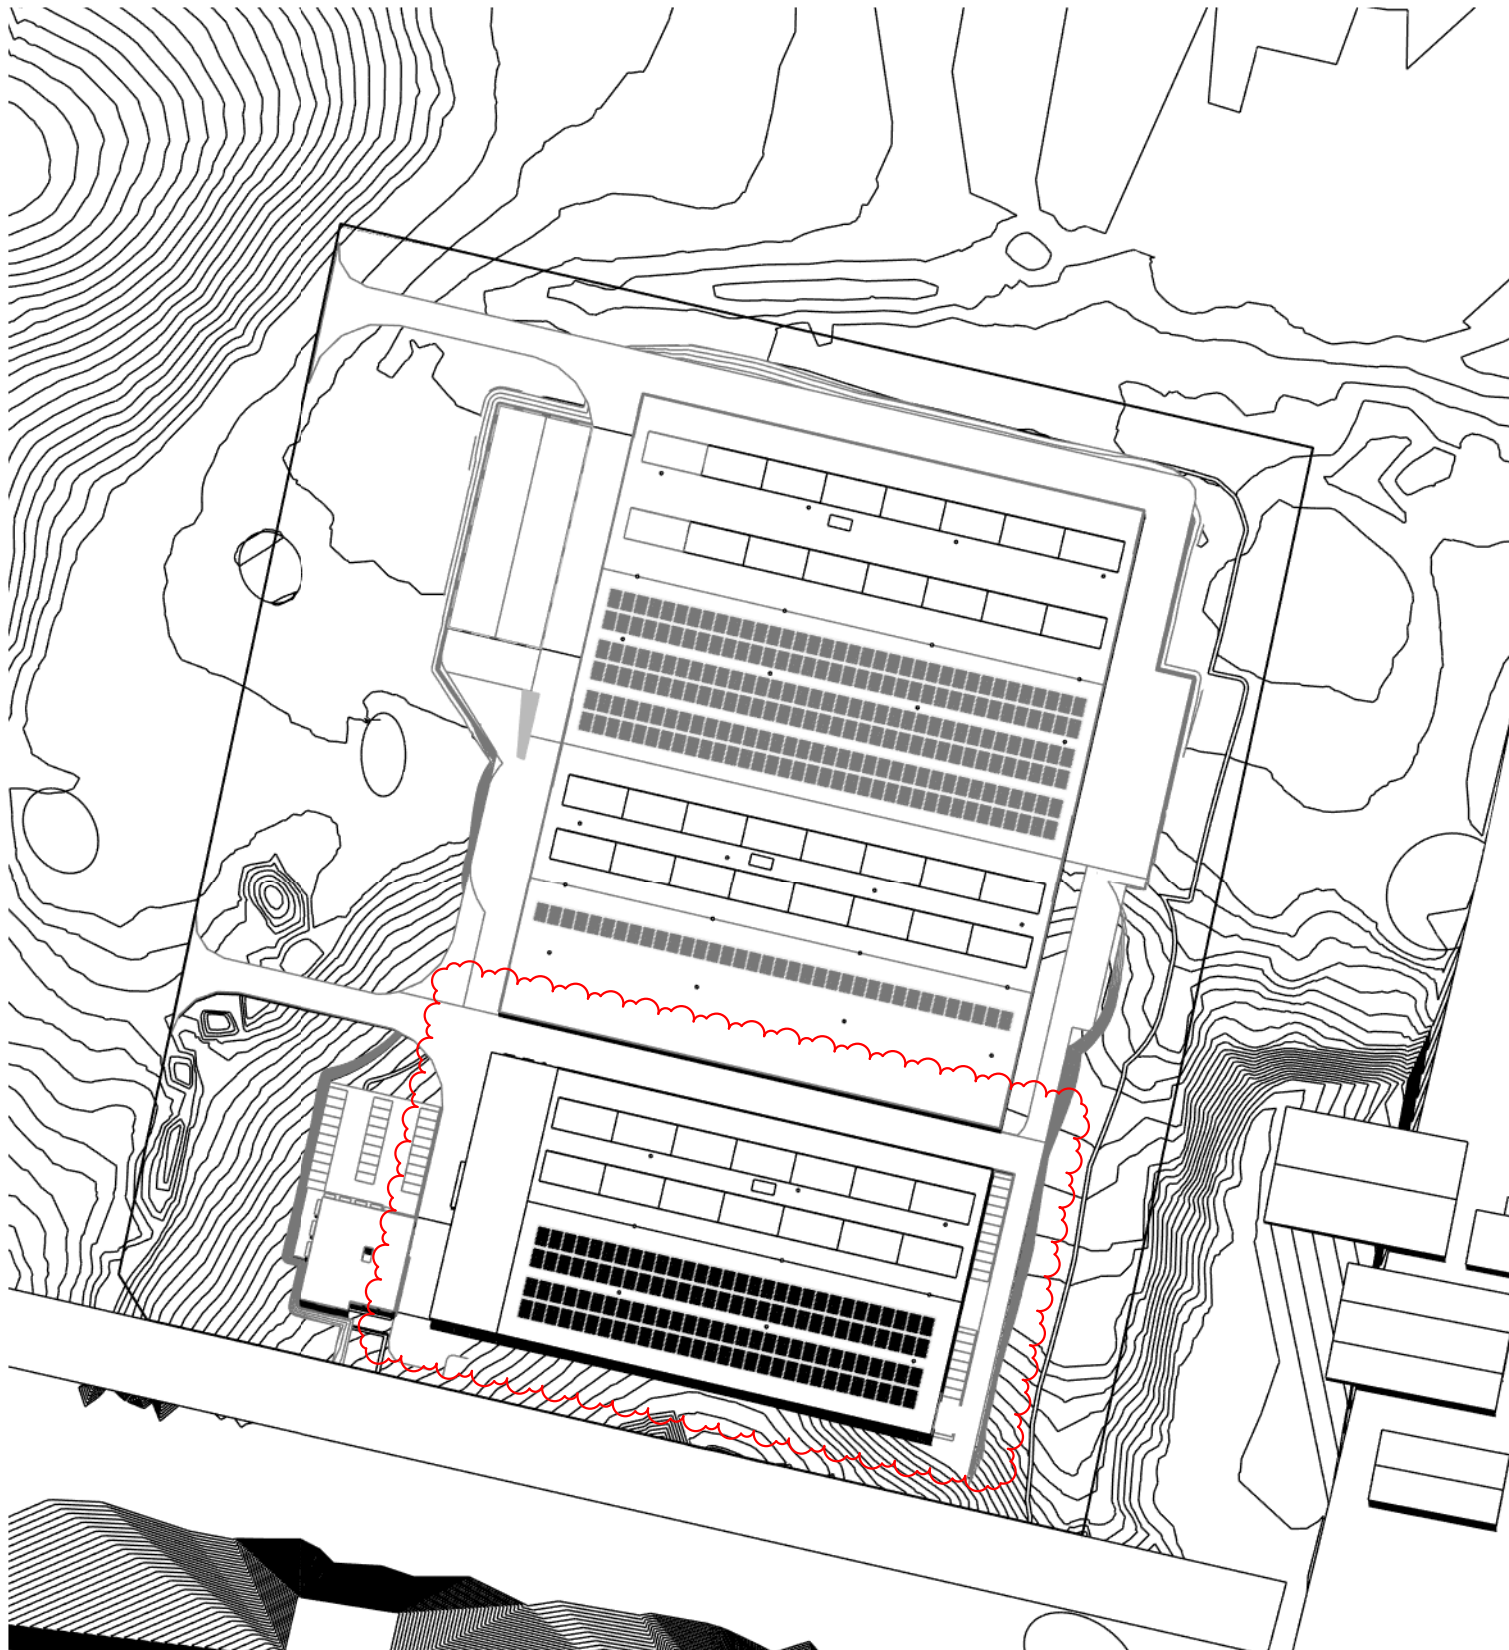


SUMMER SOLSTICE - 12PM

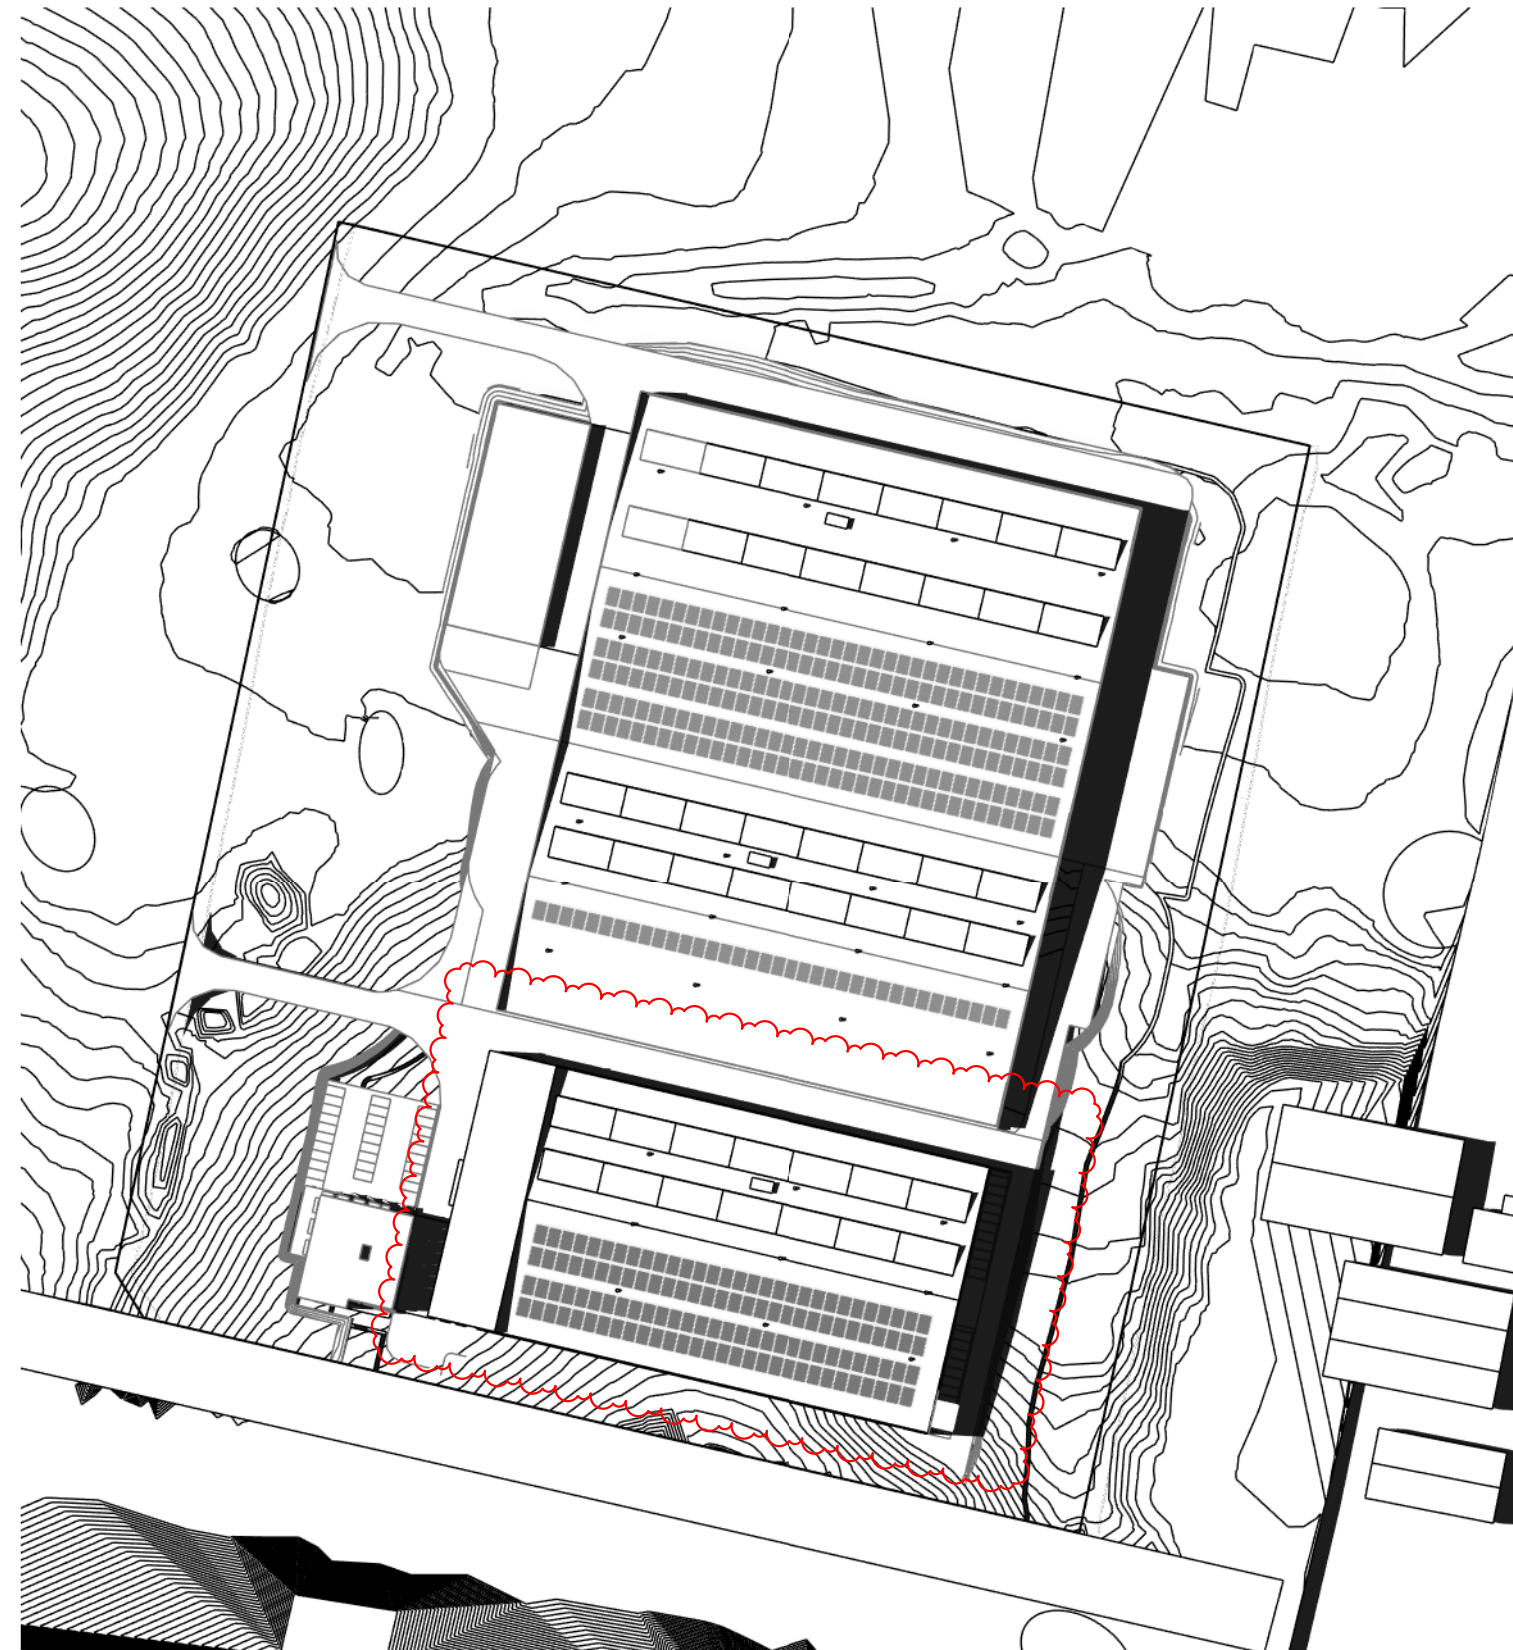


SUMMER SOLSTICE - 3PM

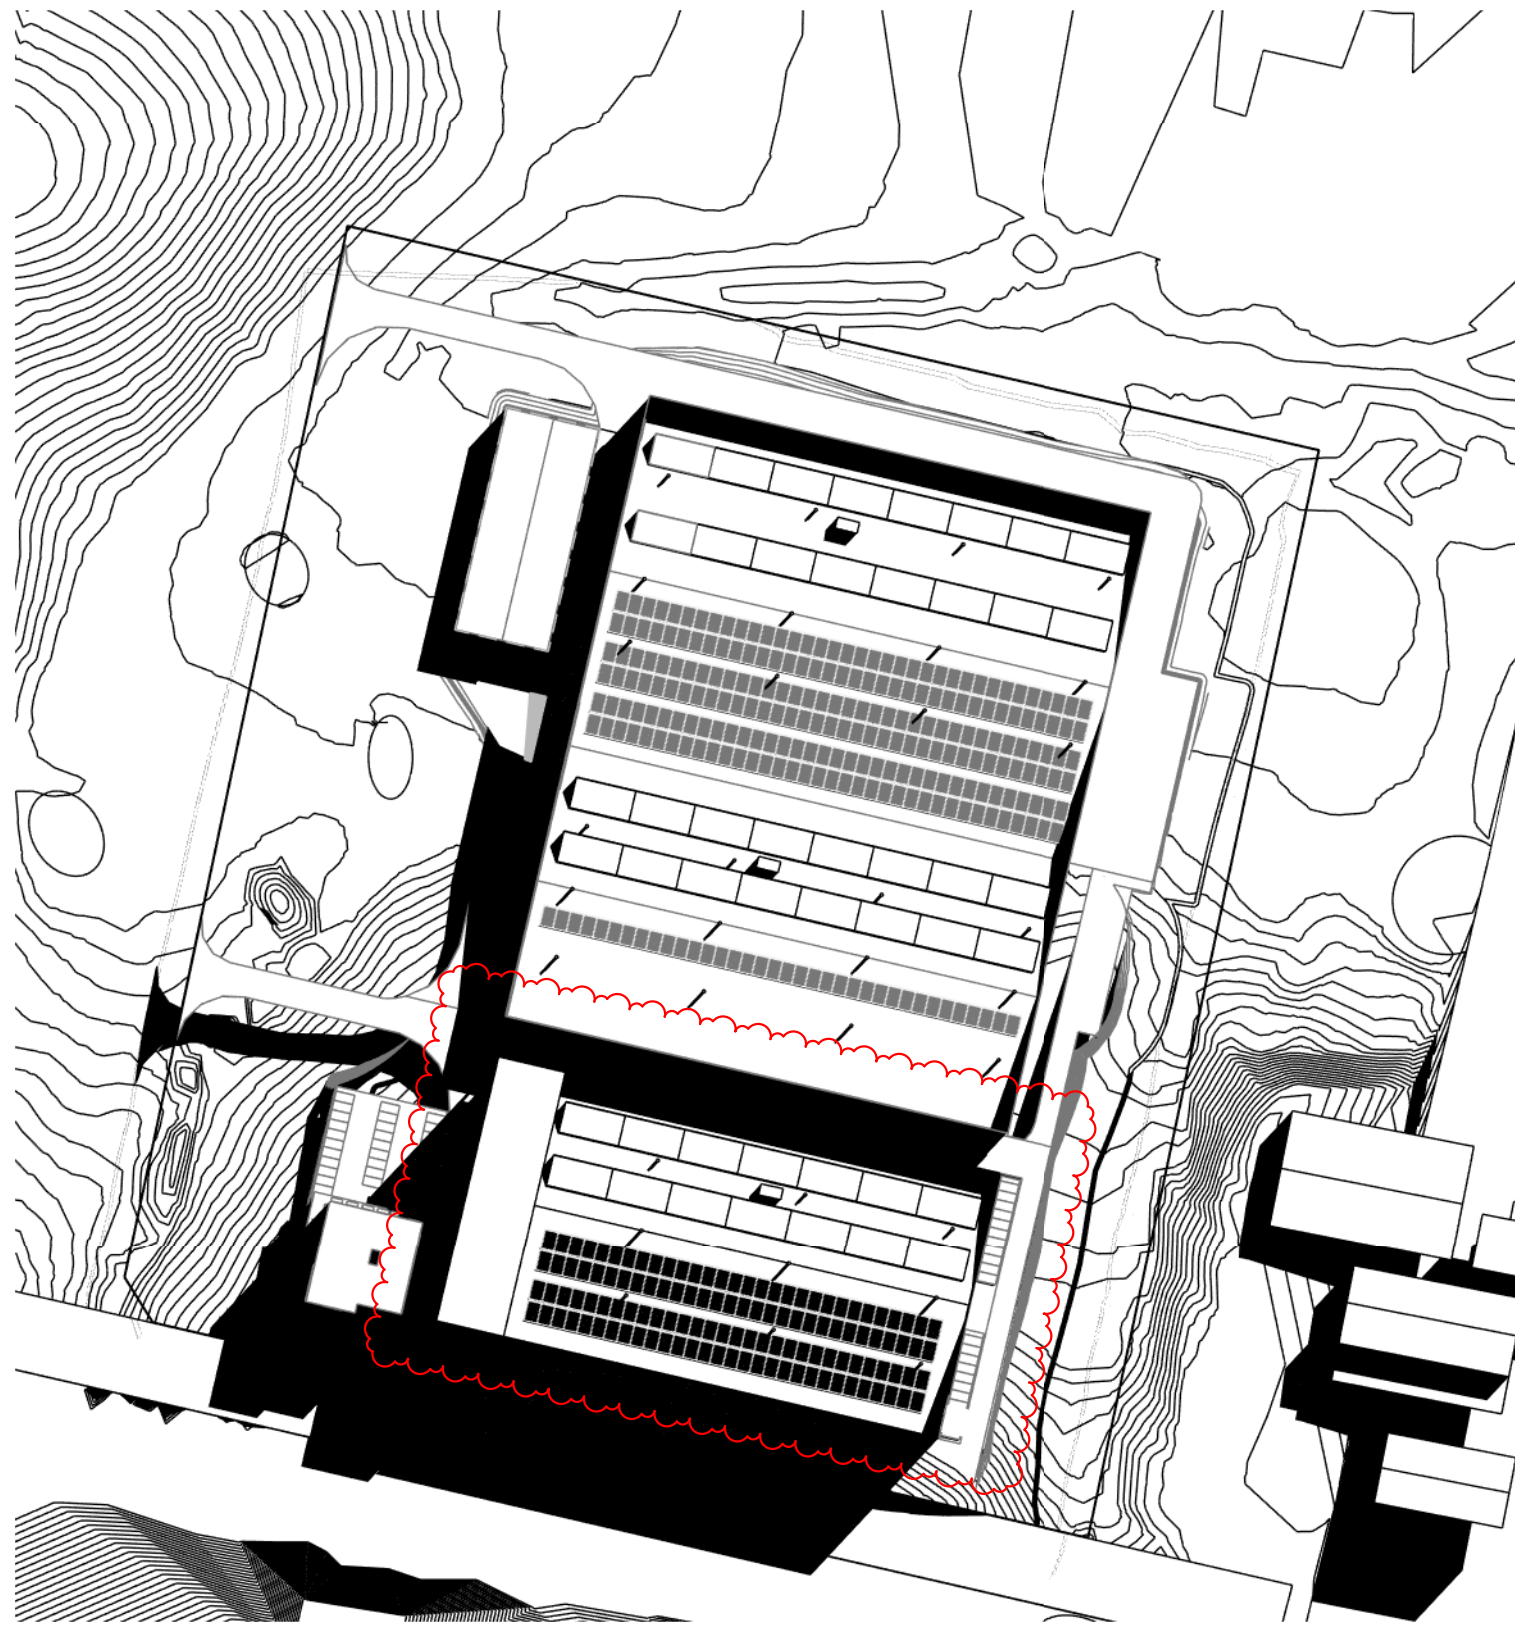

WINTER SOLSTICE - 9AM


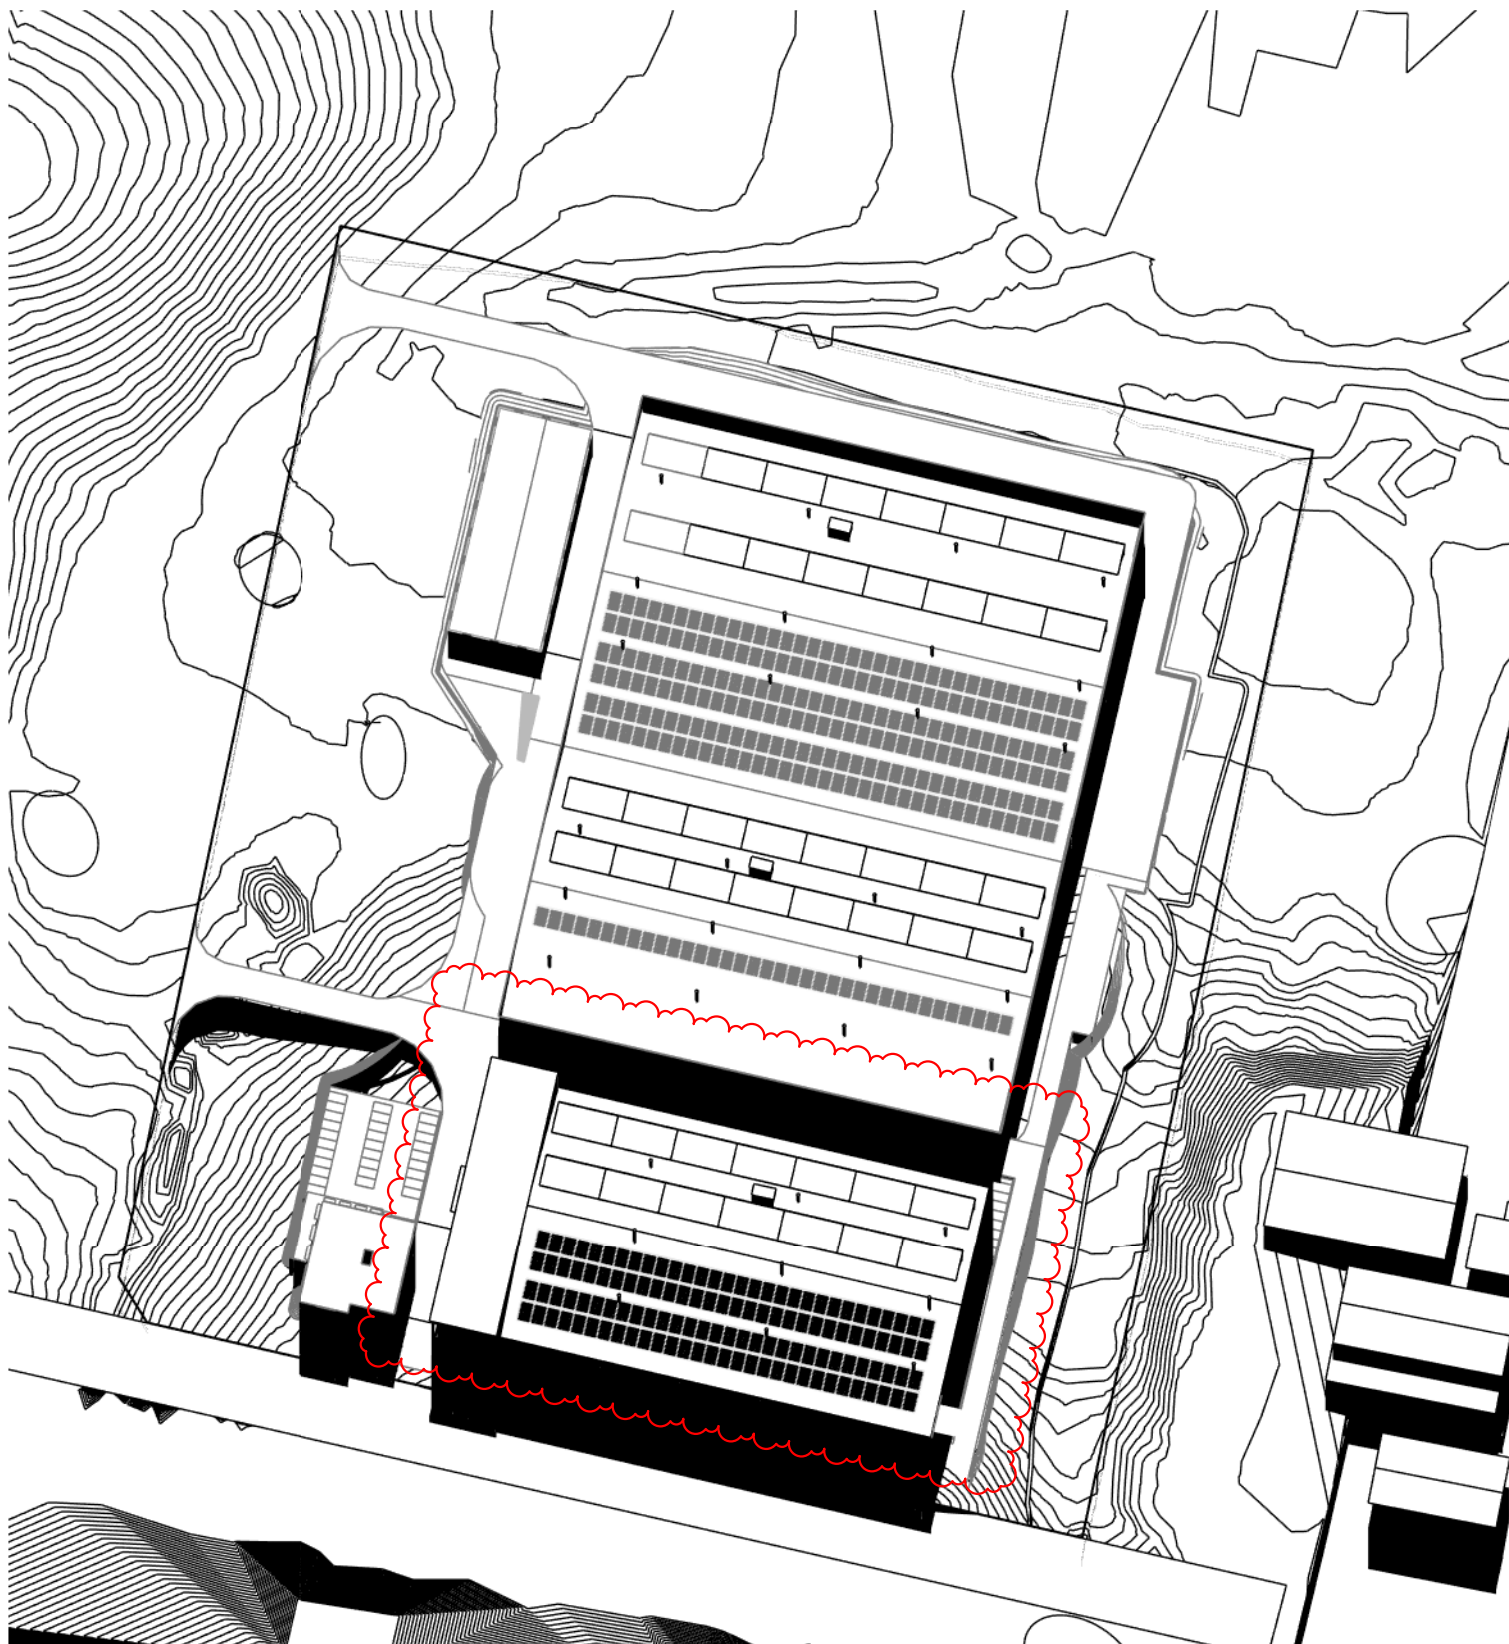


WINTER SOLSTICE - 12PM

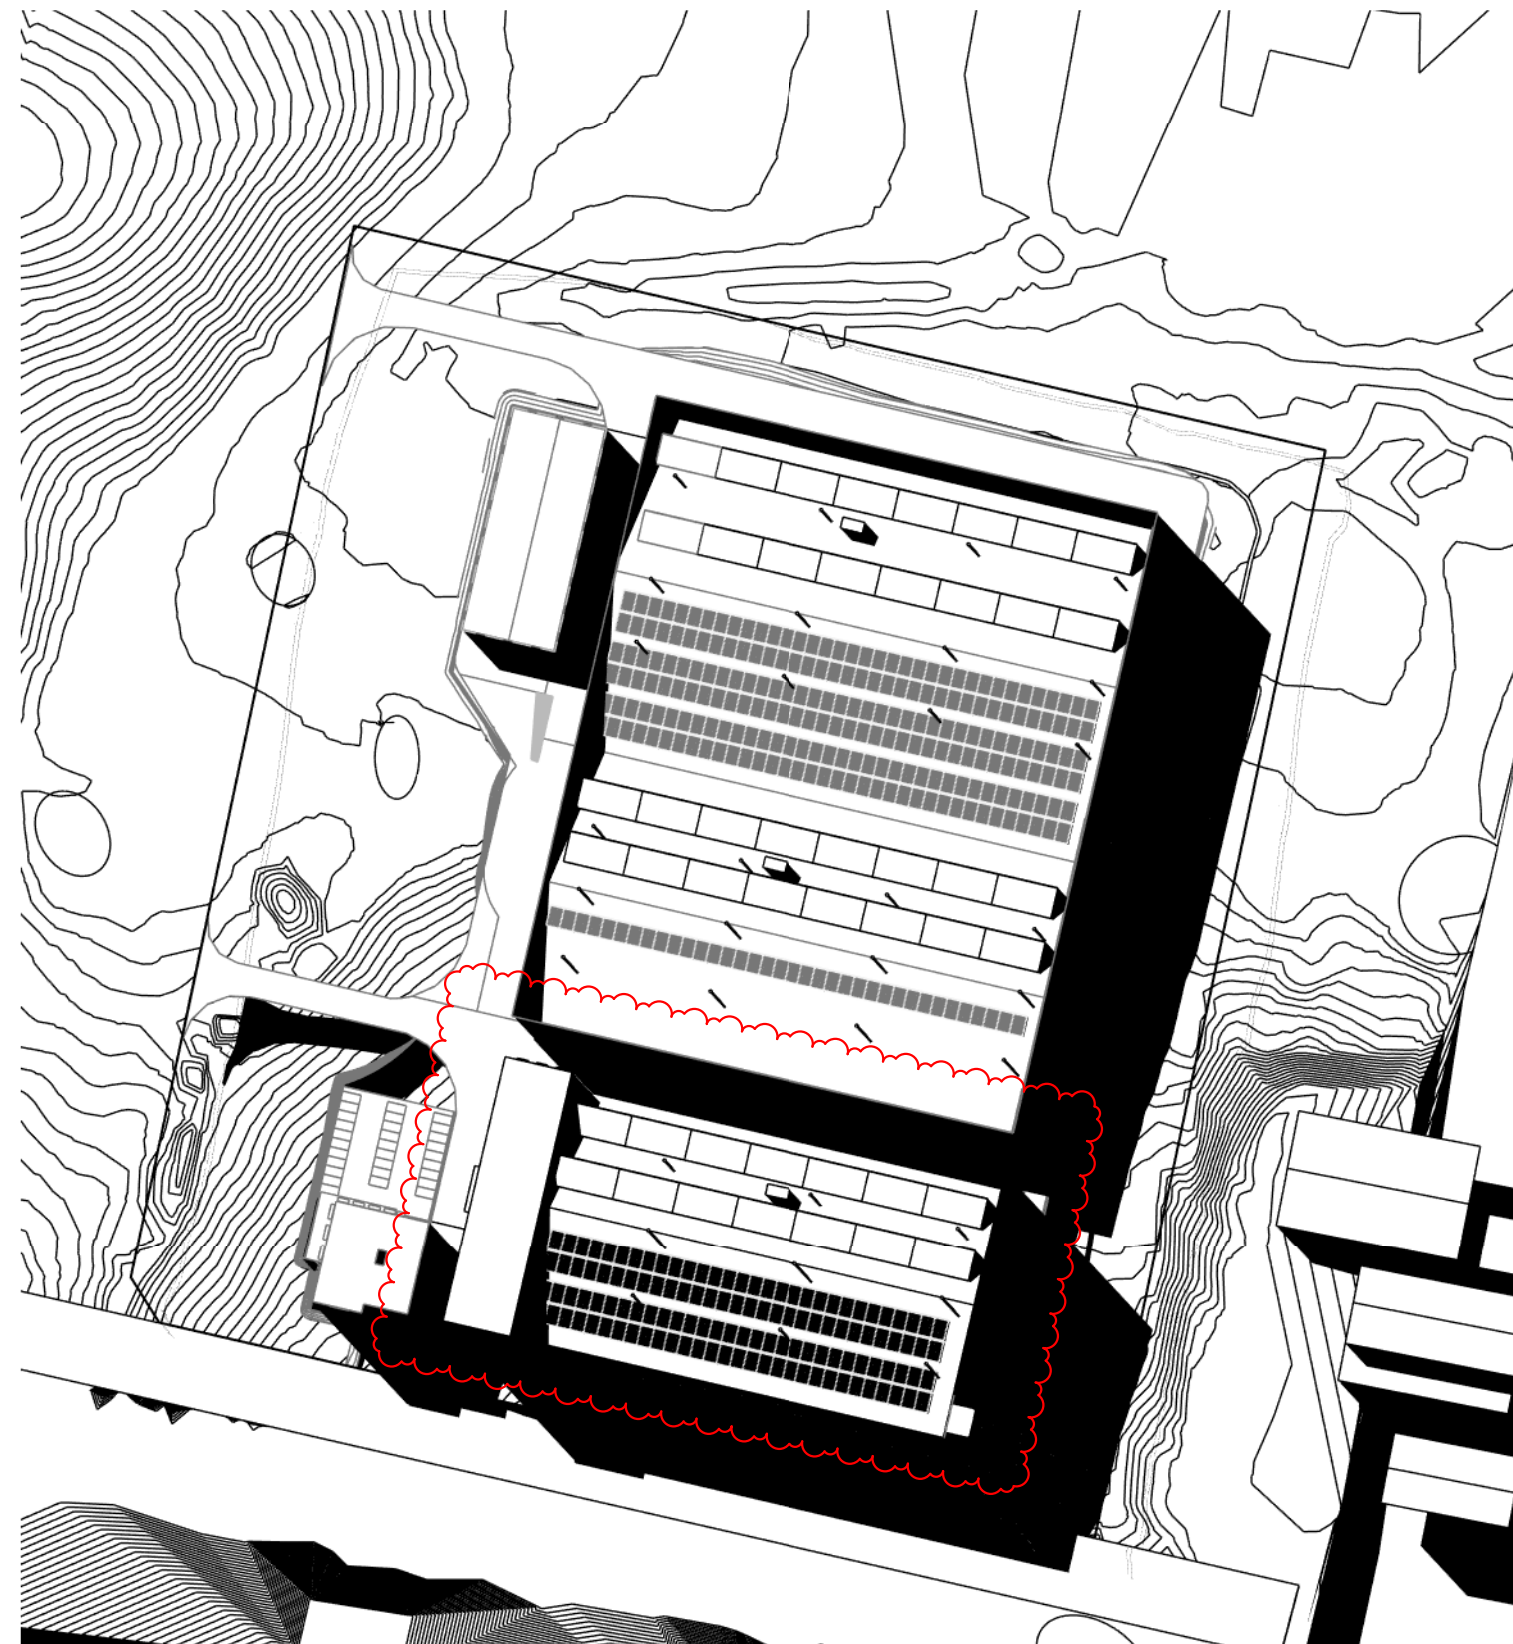

WINTER SOLSTICE - 3PM

Rev	Description	Checked	Approved	Date
G	ISSUED FOR MOSS VALE APPEAL SUPPORT	L.C.	D.G.	17.07.25
F	ISSUED FOR MOSS VALE APPEAL SUPPORT	L.C.	D.G.	04.07.25
E	ISSUED FOR EIS	L.C.	D.G.	20.04.24
D	ISSUED FOR EIS	L.C.	D.G.	19.04.24
C	ISSUED FOR EIS	L.C.	D.G.	14.03.24
B	ISSUED FOR EIS	L.C.	D.G.	01.02.24
Rev	Description	Checked	Approved	Date
Drafting Check	S.HO	Reg Architect	L.COLLINS	
Design Check	L.COLLINS	State and Reg No.	NSW 11483	

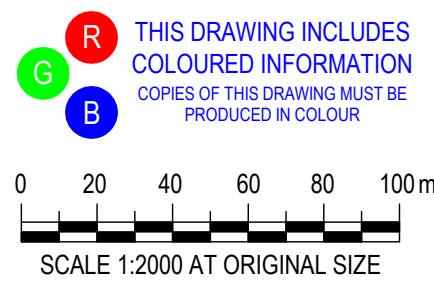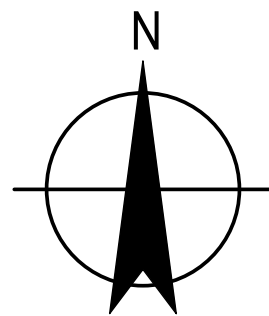

THIS DRAWING INCLUDES
COLOURED INFORMATION
COPIES OF THIS DRAWING MUST BE
PRODUCED IN COLOUR



Level 15, 133 Castlereagh Street
Sydney NSW 2000 Australia
T 61 2 9239 7100 F 61 2 9239 7199
E sydm@ghd.com W www.ghd.com/design
Conditions of Use: This document may only be used by GHD Design's client (and any other person who GHD Design has agreed can use this document) for the purpose for which it was prepared and must not be used by any other person or for any other purpose.




Nominated Architects:
Chris Asovski NSW 6843
Daphne Cheong NSW 9410
Lae Collins NSW 11483
Annie Tsang NSW 8408
Project No.
12673448

Client **REPOLY PTY LTD**
Project **MOSS VALE PLASTICS RECYCLING AND REPROCESSING FACILITY**
Status **FOR INFORMATION ONLY**



Drawing Title **SHADOW ANALYSIS**

Drawing No.
12673448-02

Size
A1
Rev
G

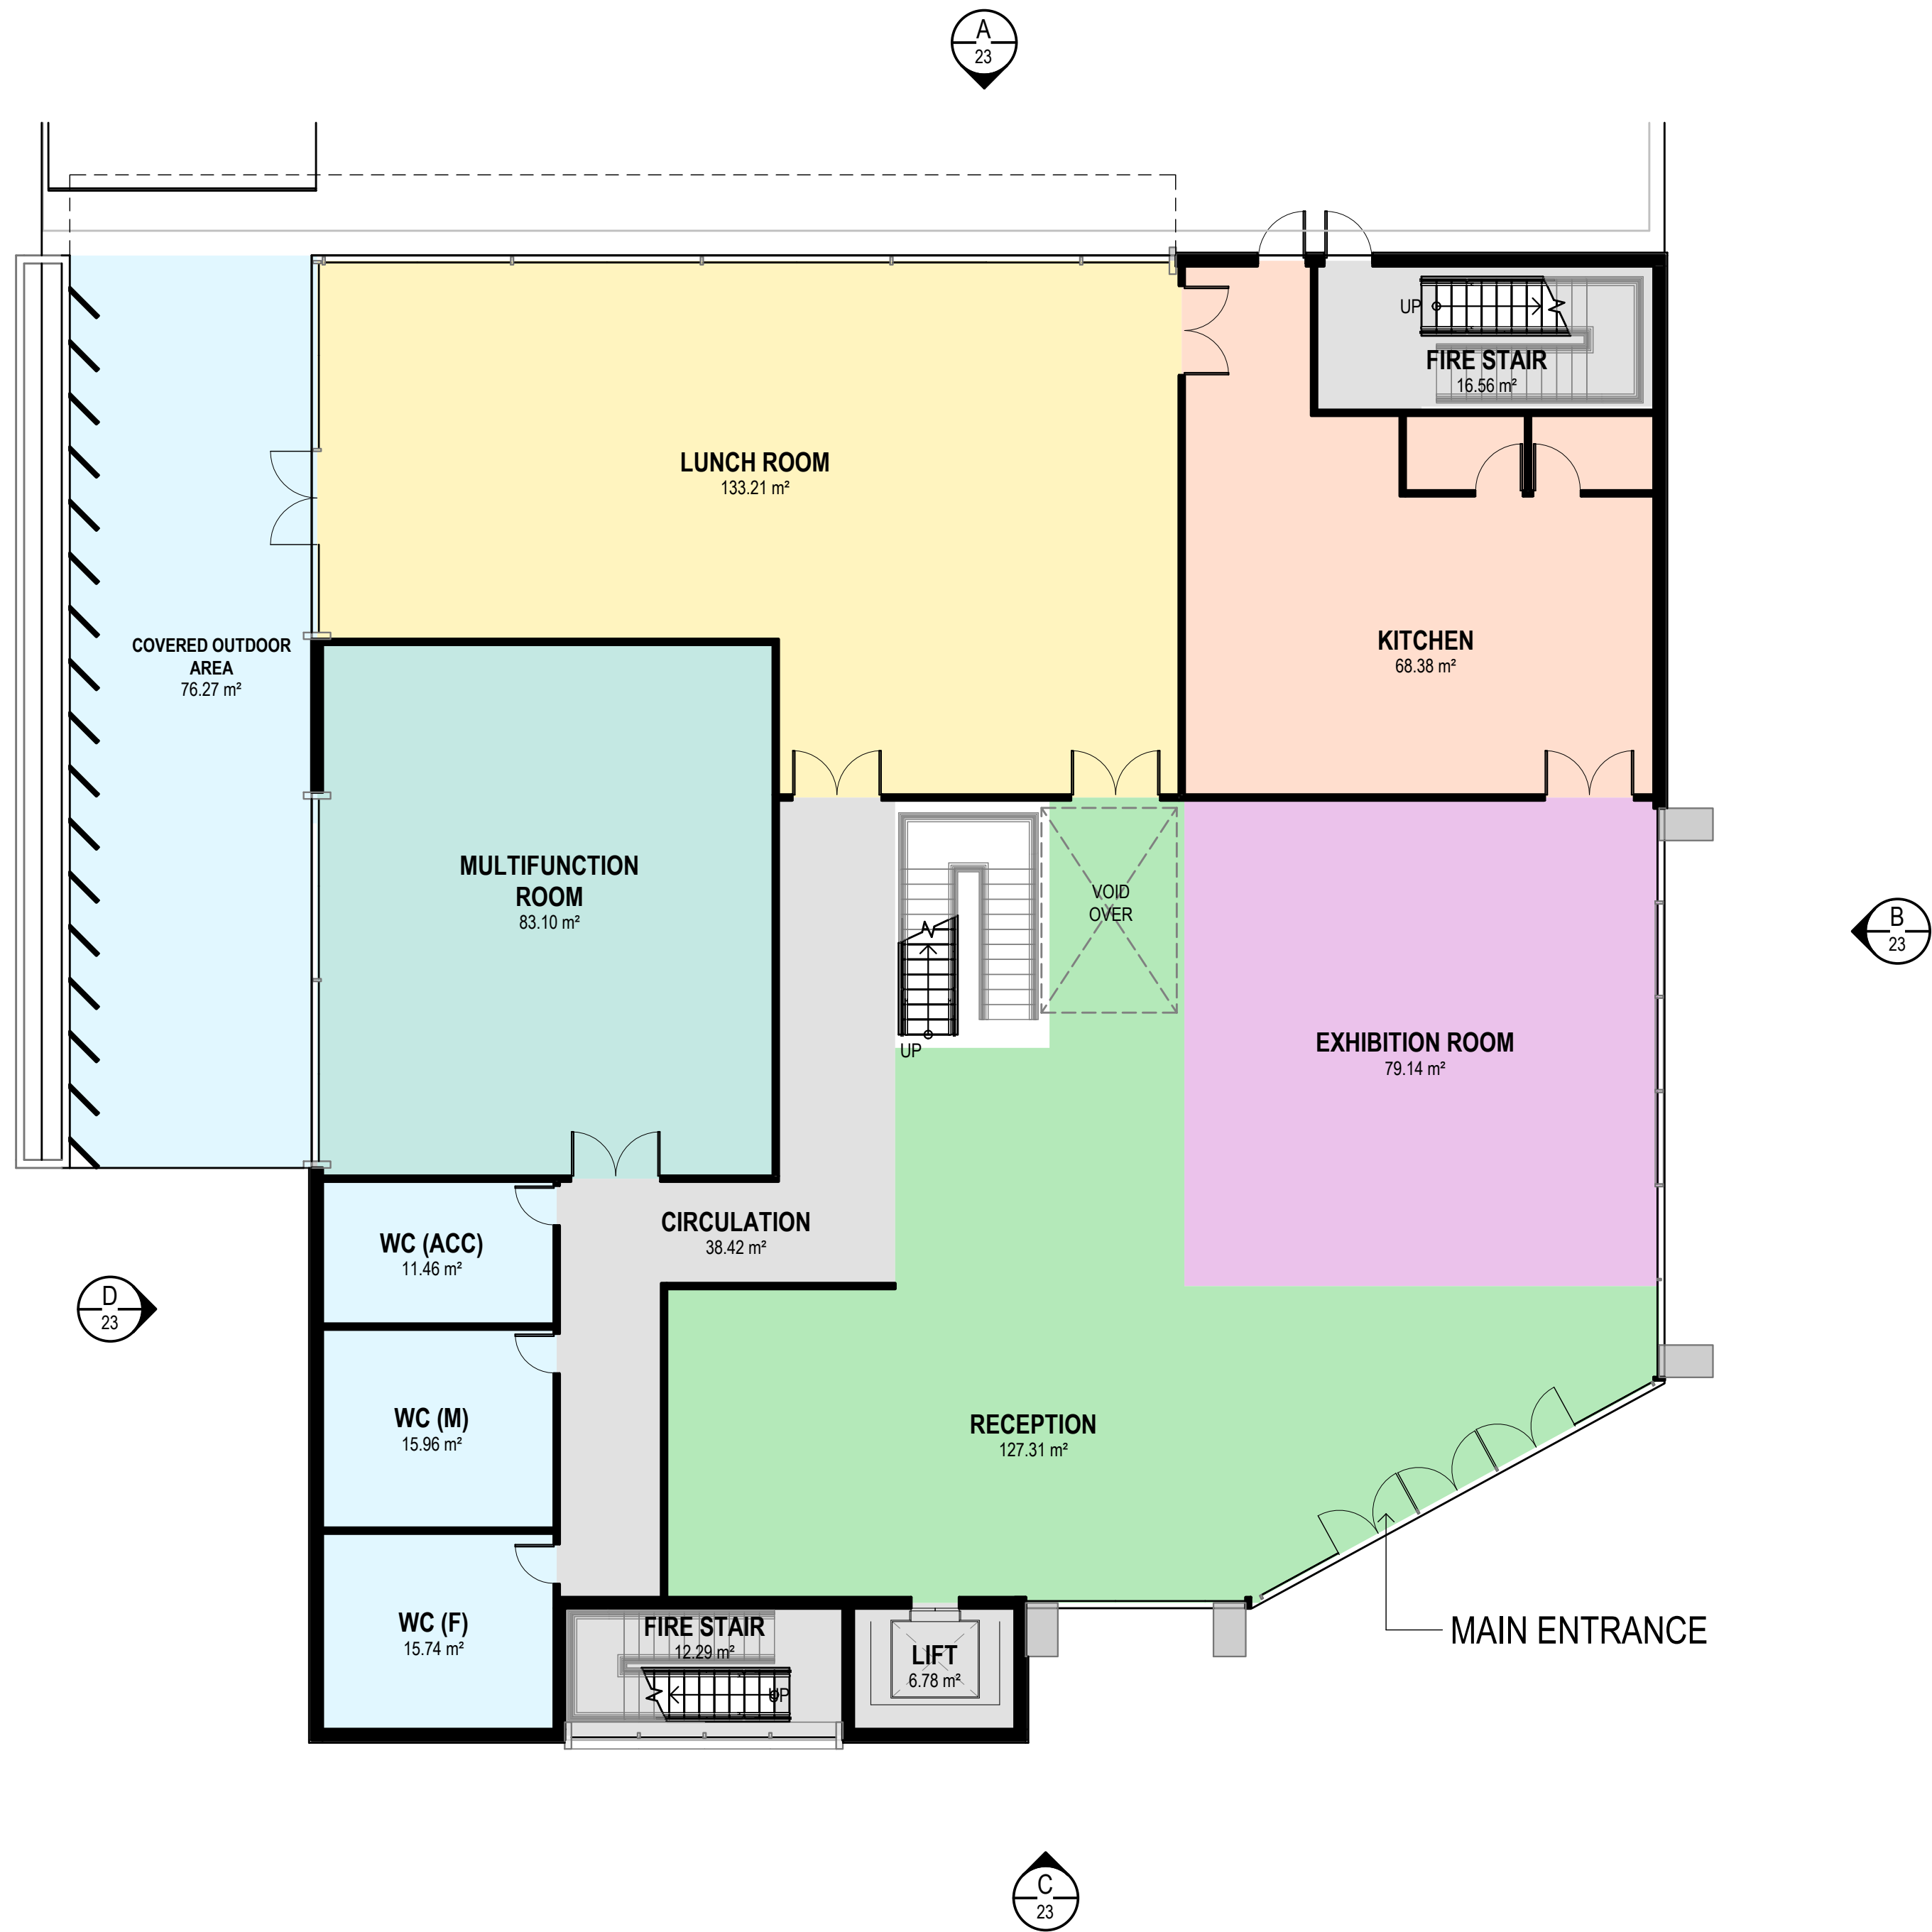

E	ISSUED FOR MOSS VALE APPEAL SUPPORT	L.C.	D.G.	17.07.25
D	ISSUED FOR EIS	L.C.	D.G.	20.04.24
C	ISSUED FOR EIS	L.C.	D.G.	14.03.24
B	ISSUED FOR EIS	L.C.	D.G.	01.02.24
A	ISSUED FOR EIS	L.C.	D.G.	20.12.23
Rev	Description	Checked	Approved	Date
Drafting Check S.HO		Reg Architect L.COLLINS		
Design Check L.COLLINS		State and Reg No. NSW 11483		

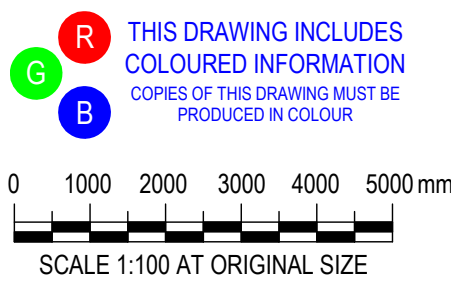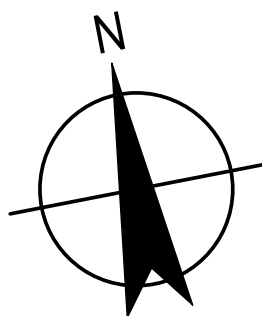

Level 15, 133 Castlereagh Street
Sydney NSW 2000 Australia
T 61 2 9239 7100 F 61 2 9239 7199
E sydney@ghd.com W www.ghd.com/design
Conditions of Use: This document may only be used by GHD Design's client (and any other person who GHD Design has agreed can use this document) for the purpose for which it was prepared and must not be used by any other person or for any other purpose.



Nominated Architects:
Chris Asovski NSW 6843
Daphne Cheong NSW 9410
Lae Collins NSW 11483
Annie Tsang NSW 8408

Project No.
12673448

Client	REPOLY PTY LTD
Project	MOSS VALE PLASTICS RECYCLING AND REPROCESSING FACILITY
Status	FOR INFORMATION ONLY

Drawing Title ADMIN BUILDING - GROUND PLAN



Drawing No.
12673448-20

Size
A1

Rev
E



F	ISSUED FOR MOSS VALE APPEAL SUPPORT	L.C.	D.G.	17.07.25
E	ISSUED FOR EIS	L.C.	D.G.	20.04.24
D	ISSUED FOR EIS	L.C.	D.G.	19.04.24
C	ISSUED FOR EIS	L.C.	D.G.	14.03.24
B	ISSUED FOR EIS	L.C.	D.G.	01.02.24
A	ISSUED FOR EIS	L.C.	D.G.	20.12.23
Rev	Description	Checked	Approved	Date
Drafting Check	S.HO	Reg Architect	L.COLLINS	
Design Check	L.COLLINS	State and Reg No.	NSW 11483	

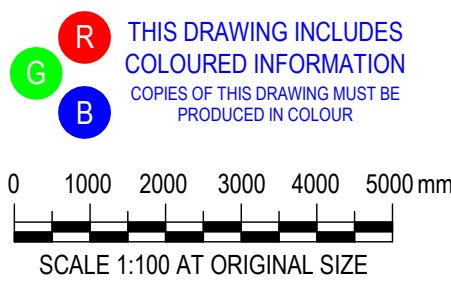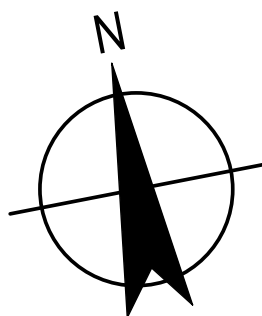

Level 15, 133 Castlereagh Street
Sydney NSW 2000 Australia
T 61 2 9239 7100 F 61 2 9239 7199
E sydmali@ghd.com W www.ghd.com/design
Conditions of Use: This document may only be used by GHD Design's client (and any other person who GHD Design has agreed can use this document) for the purpose for which it was prepared and must not be used by any other person or for any other purpose.



Nominated Architects:
Chris Asovski NSW 6843
Daphne Cheong NSW 9410
Lee Collins NSW 11483
Annie Tsang NSW 8408

Project No.
12673448

Client	REPOLY PTY LTD
Project	MOSS VALE PLASTICS RECYCLING AND REPROCESSING FACILITY
Status	FOR INFORMATION ONLY

Drawing Title ADMIN BUILDING - LEVEL 1 PLAN



Drawing No.
12673448-21

Size
A1

Rev
F



F	ISSUED FOR MOSS VALE APPEAL SUPPORT	L.C.	D.G.	17.07.25
E	ISSUED FOR EIS	L.C.	D.G.	20.04.24
D	ISSUED FOR EIS	L.C.	D.G.	19.04.24
C	ISSUED FOR EIS	L.C.	D.G.	14.03.24
B	ISSUED FOR EIS	L.C.	D.G.	01.02.24
A	ISSUED FOR EIS	L.C.	D.G.	20.12.23
Rev	Description	Checked	Approved	Date
Drafting Check S.HO		Reg Architect L.COLLINS		
Design Check L.COLLINS		State and Reg No. NSW 11483		

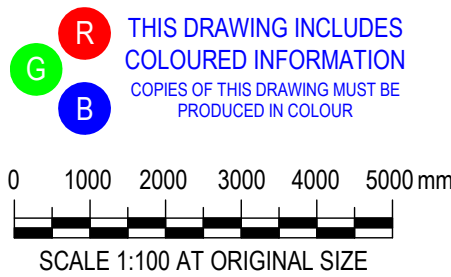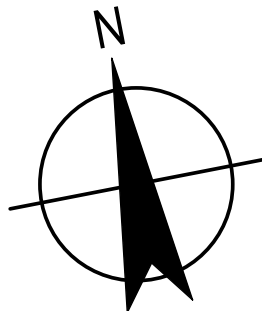

Level 15, 133 Castlereagh Street
Sydney NSW 2000 Australia
T 61 2 9239 7100 F 61 2 9239 7199
E sydney@ghd.com W www.ghd.com/design
Conditions of Use: This document may only be used by GHD Design's client (and any other person who GHD Design has agreed can use this document) for the purpose for which it was prepared and must not be used by any other person or for any other purpose.



Nominated Architects:
Chris Asovski NSW 6843
Daphne Cheong NSW 9410
Lee Collins NSW 11483
Annie Tsang NSW 8408

Project No.
12673448

Client	REPOLY PTY LTD
Project	MOSS VALE PLASTICS RECYCLING AND REPROCESSING FACILITY
Status	FOR INFORMATION ONLY

Drawing Title ADMIN BUILDING - LEVEL 2 PLAN


Drawing No.
12673448-22

Size
A1

Rev
F



F	ISSUED FOR MOSS VALE APPEAL SUPPORT	L.C.	D.G.	17.07.25
E	ISSUED FOR EIS	L.C.	D.G.	20.04.24
D	ISSUED FOR EIS	L.C.	D.G.	19.04.24
C	ISSUED FOR EIS	L.C.	D.G.	14.03.24
B	ISSUED FOR EIS	L.C.	D.G.	01.02.24
A	ISSUED FOR EIS	L.C.	D.G.	20.12.23
Rev	Description	Checked	Approved	Date
Drafting Check	S.HO	Reg Architect	L.COLLINS	
Design Check	L.COLLINS	State and Reg No.	NSW 11483	

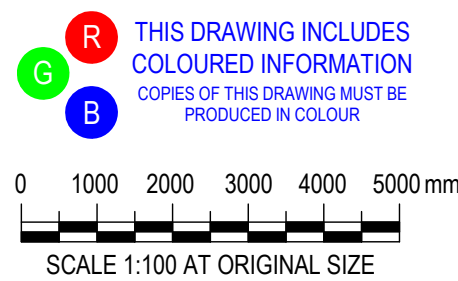

Level 15, 133 Castlereagh Street
Sydney NSW 2000 Australia
T 61 2 9239 7100 F 61 2 9239 7199
E sydney@ghd.com W www.ghd.com/design
Conditions of Use: This document may only be used by GHD Design's client (and any other person who GHD Design has agreed can use this document) for the purpose for which it was prepared and must not be used by any other person or for any other purpose.



Nominated Architects:
Chris Asovski NSW 6843
Daphne Cheong NSW 9410
Lae Collins NSW 11483
Annie Tsang NSW 8408

Project No.
12673448


Client	REPOLY PTY LTD
Project	MOSS VALE PLASTICS RECYCLING AND REPROCESSING FACILITY
Status	FOR INFORMATION ONLY

Drawing Title
ADMIN BUILDING - ELEVATIONS


Drawing No.
12673448-23

Size
A1

Rev
F

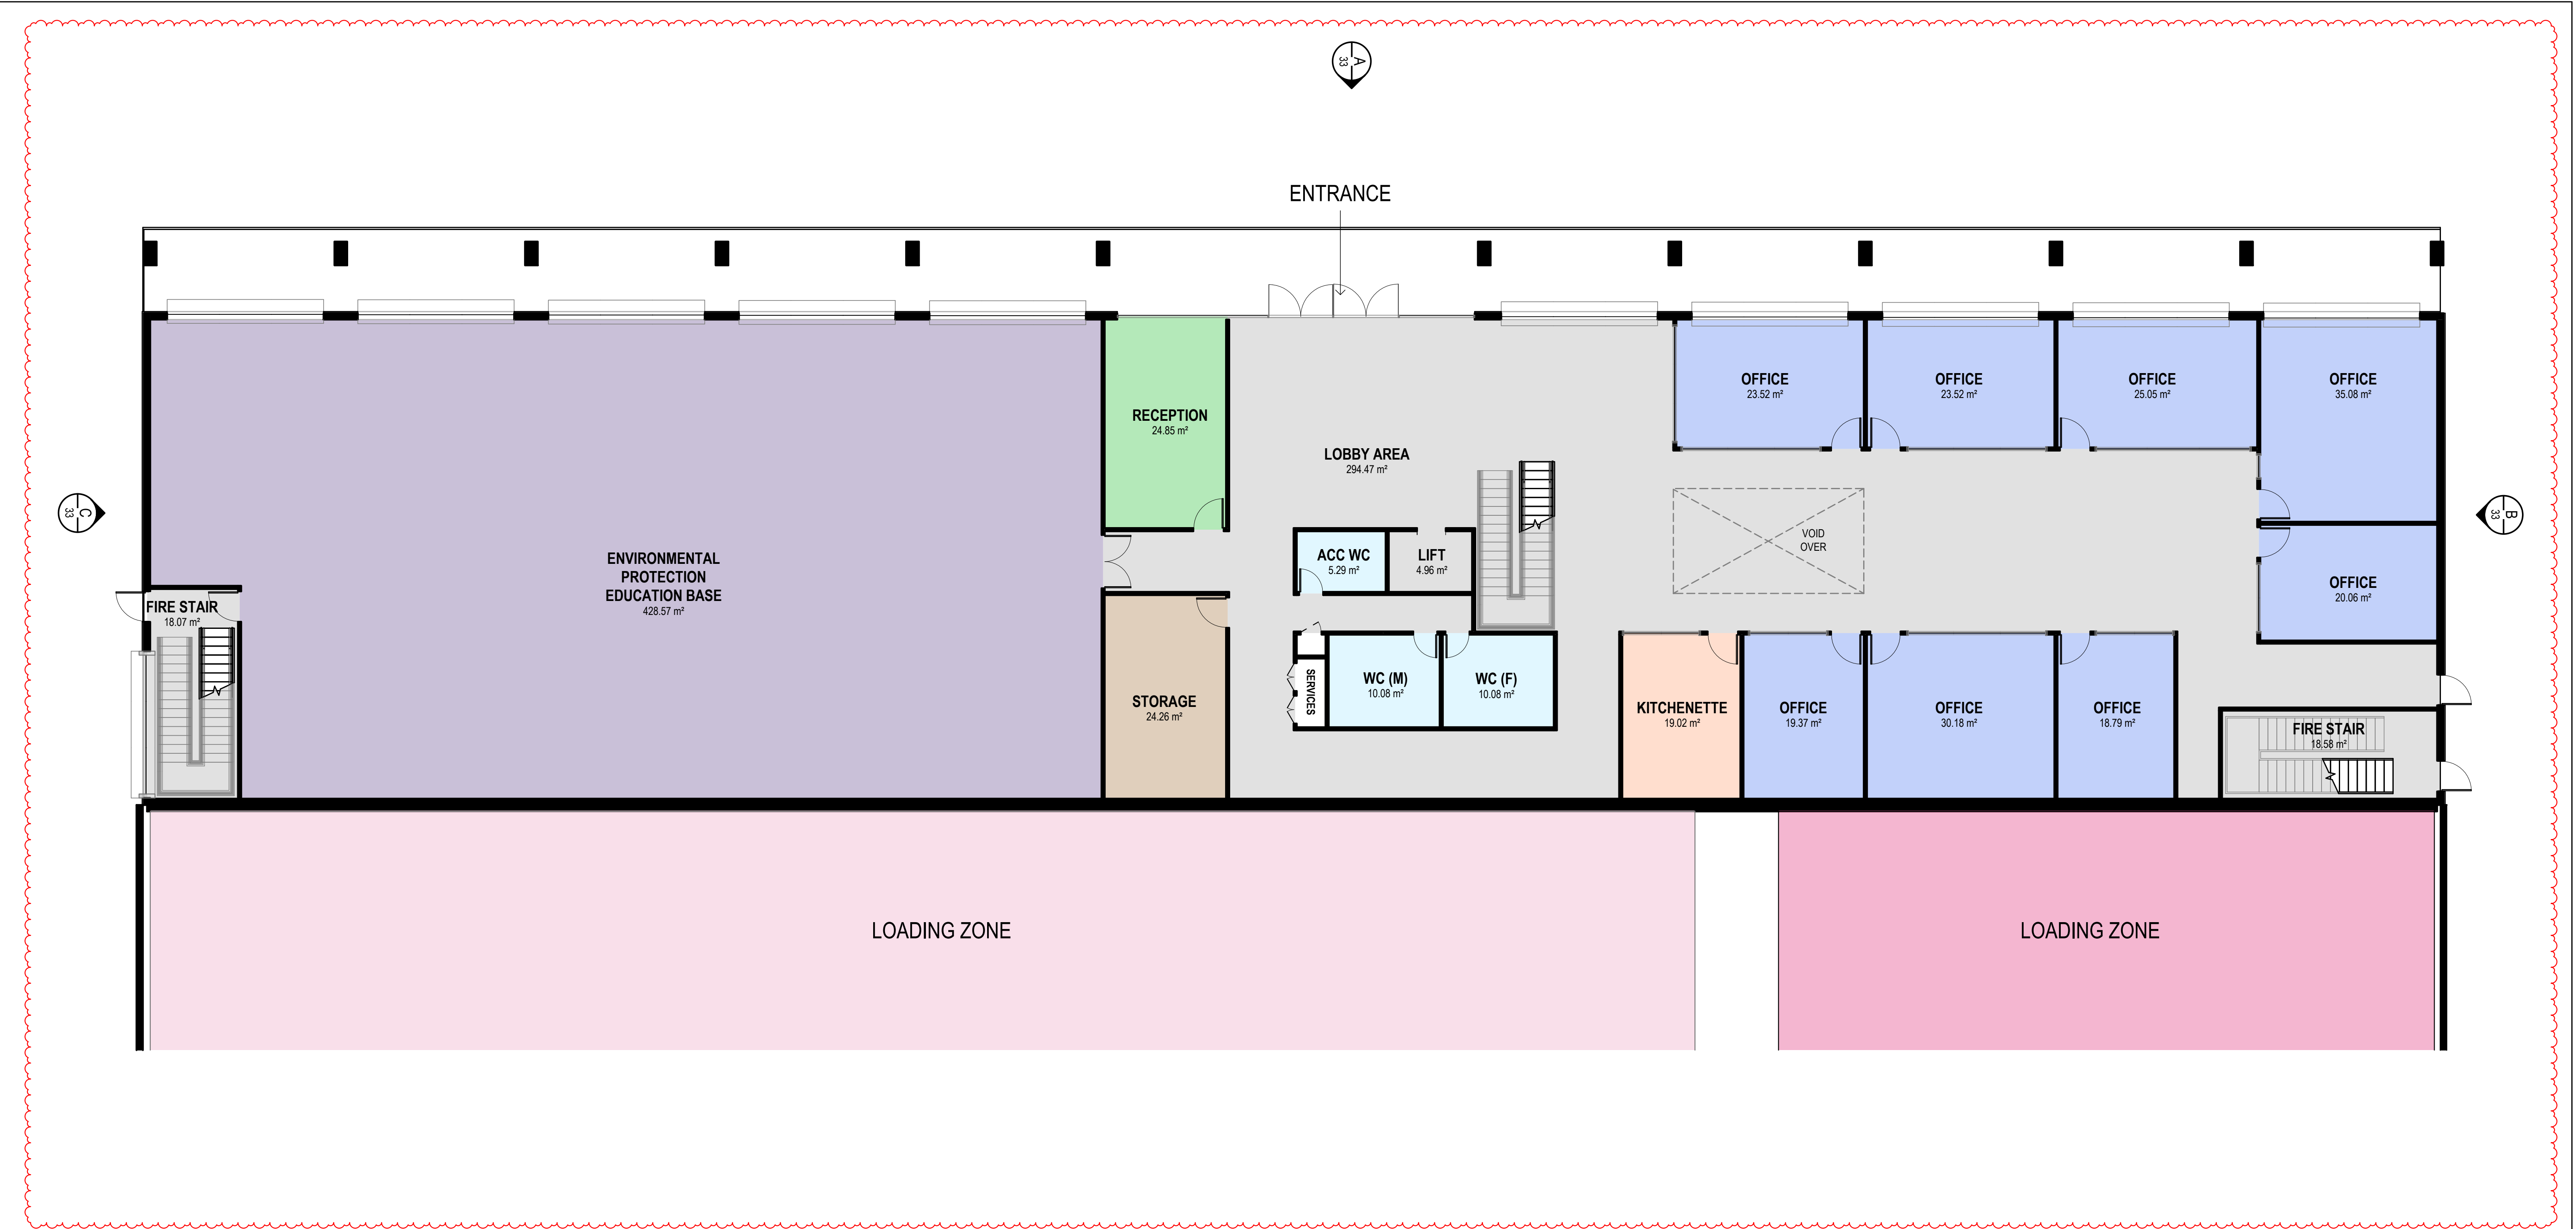

G	ISSUED FOR MOSS VALE APPEAL SUPPORT	L.C.	D.G.	17.07.25
F	ISSUED FOR MOSS VALE APPEAL SUPPORT	L.C.	D.G.	14.07.25
E	ISSUED FOR EIS	L.C.	D.G.	20.04.24
D	ISSUED FOR EIS	L.C.	D.G.	19.04.24
C	ISSUED FOR EIS	L.C.	D.G.	14.03.24
B	ISSUED FOR EIS	L.C.	D.G.	01.02.24
Rev	Description	Checked	Approved	Date
Drafting Check	S.HO	Reg Architect	L.COLLINS	
Design Check	L.COLLINS	State and Reg No.	NSW 11483	

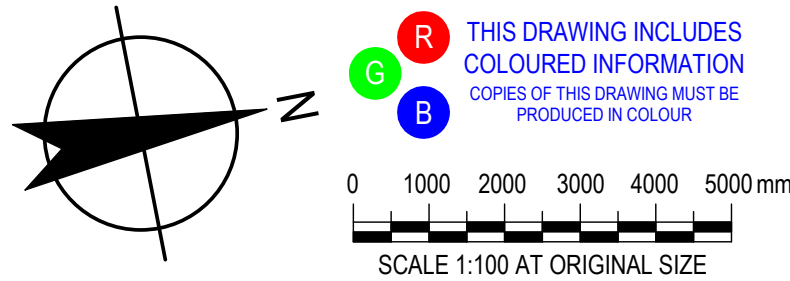

Level 15, 133 Castlereagh Street
Sydney NSW 2000 Australia
T 61 2 9239 7100 F 61 2 9239 7199
E sydney@ghd.com W www.ghd.com/design
Conditions of Use: This document may only be used by GHD Design's client (and any other person who GHD Design has agreed can use this document) for the purpose for which it was prepared and must not be used by any other person or for any other purpose.



Nominated Architects:
Chris Asovski NSW 6843
Daphne Cheong NSW 9410
Lee Collins NSW 11483
Annie Tsang NSW 8408

Project No.
12673448


Client	REPOLY PTY LTD
Project	MOSS VALE PLASTICS RECYCLING AND REPROCESSING FACILITY
Status	FOR INFORMATION ONLY

Drawing Title	MULTI-USE BUILDING - GROUND PLAN
Drawing No.	12673448-30

Size	A1
Rev	G



G	ISSUED FOR MOSS VALE APPEAL SUPPORT	L.C.	D.G.	17.07.25
F	ISSUED FOR MOSS VALE APPEAL SUPPORT	L.C.	D.G.	14.07.25
E	ISSUED FOR EIS	L.C.	D.G.	20.04.24
D	ISSUED FOR EIS	L.C.	D.G.	19.04.24
C	ISSUED FOR EIS	L.C.	D.G.	14.03.24
B	ISSUED FOR EIS	L.C.	D.G.	01.02.24
Rev	Description	Checked	Approved	Date
Drafting Check	S.HO	Reg Architect	L.COLLINS	
Design Check	L.COLLINS	State and Reg No.	NSW 11483	

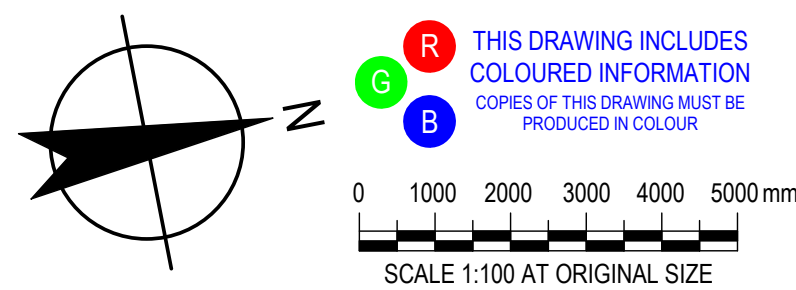

Level 15, 133 Castlereagh Street
Sydney NSW 2000 Australia
T 61 2 9239 7100 F 61 2 9239 7199
E sydmali@ghd.com W www.ghd.com/design
Conditions of Use: This document may only be used by GHD Design's client (and any other person who GHD Design has agreed can use this document) for the purpose for which it was prepared and must not be used by any other person or for any other purpose.



Nominated Architects:
Chris Asovski NSW 6843
Daphne Cheong NSW 9410
Lae Collins NSW 11483
Annie Tsang NSW 8408

Project No.
12673448

Client
REPOLY PTY LTD

Project
MOSS VALE PLASTICS RECYCLING AND
REPROCESSING FACILITY

Status
FOR INFORMATION ONLY

Drawing Title
MULTI-USE BUILDING - LEVEL 1 PLAN


Drawing No.
12673448-31

Size
A1

Rev
G



G	ISSUED FOR MOSS VALE APPEAL SUPPORT	L.C.	D.G.	17.07.25
F	ISSUED FOR MOSS VALE APPEAL SUPPORT	L.C.	D.G.	14.07.25
E	ISSUED FOR EIS	L.C.	D.G.	20.04.24
D	ISSUED FOR EIS	L.C.	D.G.	19.04.24
C	ISSUED FOR EIS	L.C.	D.G.	14.03.24
B	ISSUED FOR EIS	L.C.	D.G.	01.02.24
Rev	Description	Checked	Approved	Date
Drafting Check S.HO		Reg Architect L.COLLINS		
Design Check L.COLLINS		State and Reg No. NSW 11483		

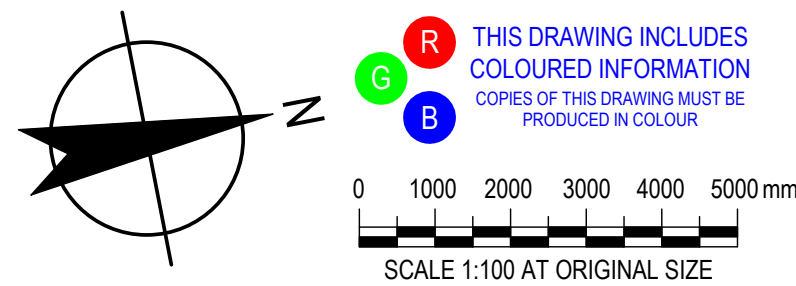

Level 15, 133 Castlereagh Street
Sydney NSW 2000 Australia
T 61 2 9239 7100 F 61 2 9239 7199
E sydmali@ghd.com W www.ghd.com/design
Conditions of Use: This document may only be used by GHD Design's client (and any other person who GHD Design has agreed can use this document) for the purpose for which it was prepared and must not be used by any other person or for any other purpose.




Nominated Architects:
Chris Asovski NSW 6843
Daphne Cheong NSW 9410
Lae Collins NSW 11483
Annie Tsang NSW 8408
Project No.
12673448


Client	REPOLY PTY LTD
Project	MOSS VALE PLASTICS RECYCLING AND REPROCESSING FACILITY
Status	FOR INFORMATION ONLY

Drawing Title	MULTI-USE BUILDING - LEVEL 2 PLAN
Drawing No.	12673448-32

Size
A1
Rev
G

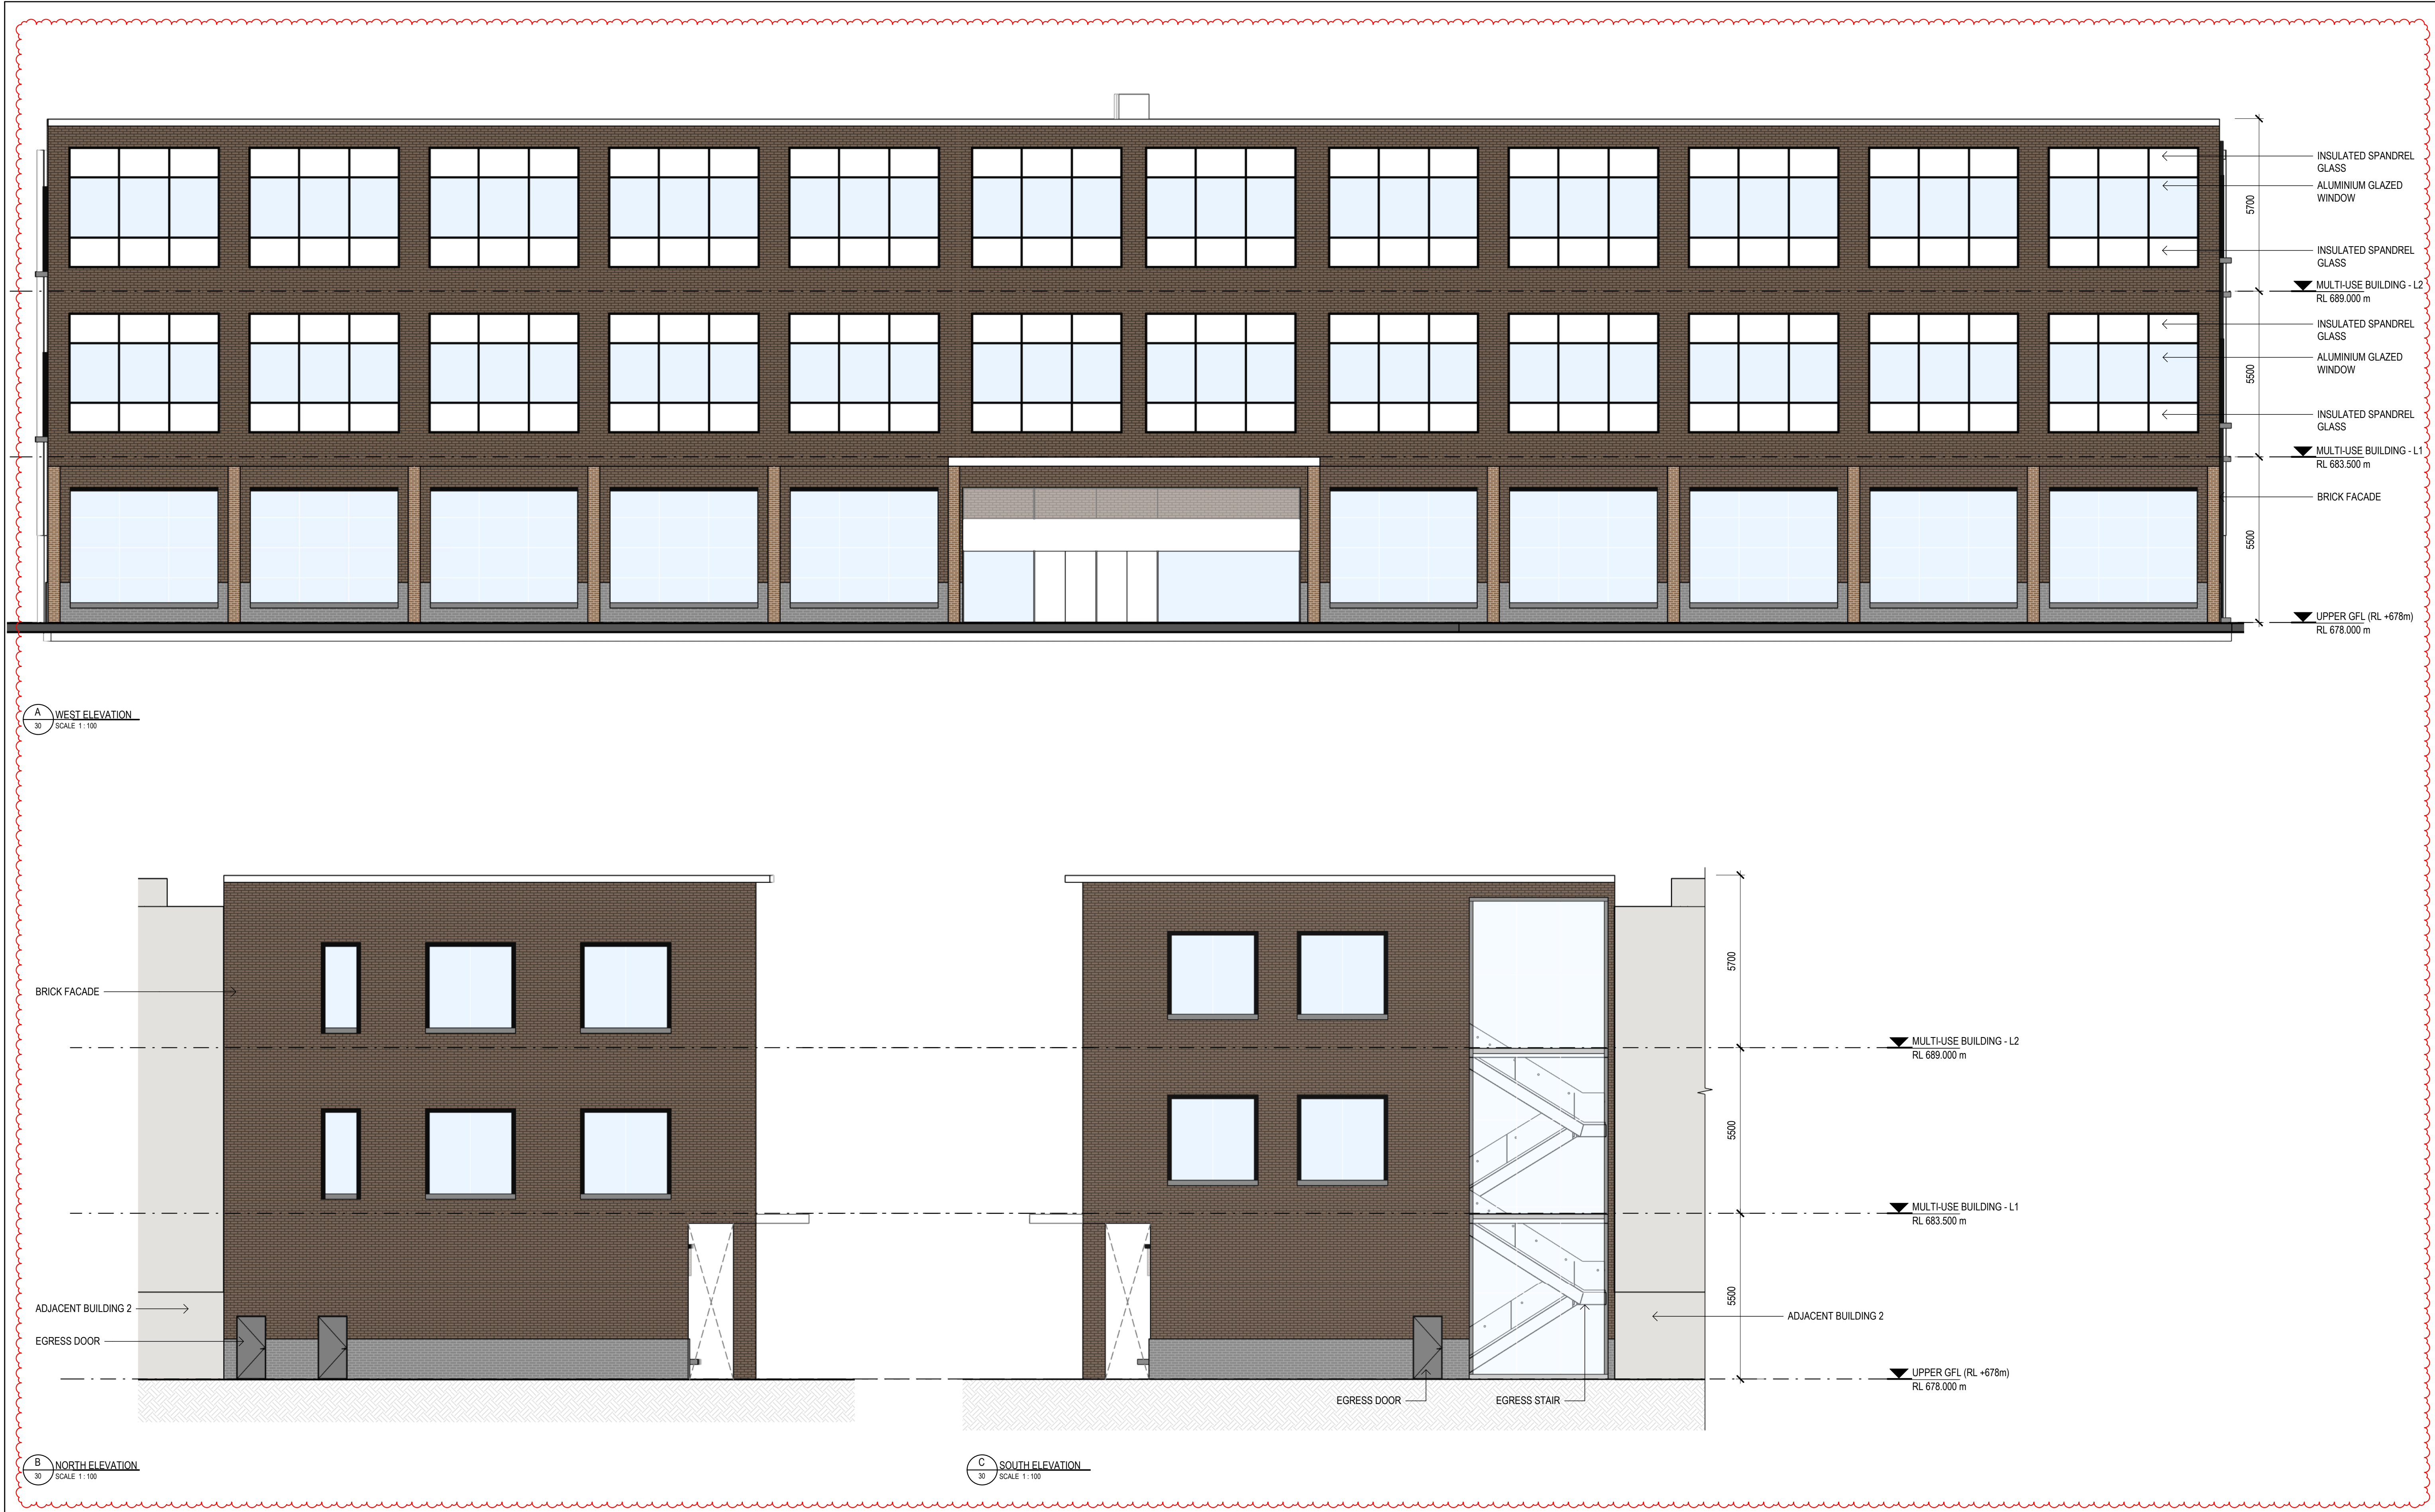

G	ISSUED FOR MOSS VALE APPEAL SUPPORT	L.C.	D.G.	17.07.25
F	ISSUED FOR MOSS VALE APPEAL SUPPORT	L.C.	D.G.	14.07.25
E	ISSUED FOR EIS	L.C.	D.G.	20.04.24
D	ISSUED FOR EIS	L.C.	D.G.	19.04.24
C	ISSUED FOR EIS	L.C.	D.G.	14.03.24
B	ISSUED FOR EIS	L.C.	D.G.	01.02.24
Rev	Description	Checked	Approved	Date
Drafting Check	S.HO	Reg Architect	L.COLLINS	
Design Check	L.COLLINS	State and Reg No.	NSW 11483	

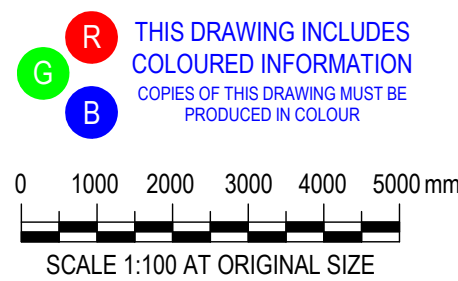

Level 15, 133 Castlereagh Street
Sydney NSW 2000 Australia
T 61 2 9239 7100 F 61 2 9239 7199
E sydney@ghd.com W www.ghd.com/design
Conditions of Use: This document may only be used by GHD Design's client (and any other person who GHD Design has agreed can use this document) for the purpose for which it was prepared and must not be used by any other person or for any other purpose.




Nominated Architects:
Chris Asenki NSW 6843
Daphne Chong NSW 9410
Lee Collins NSW 11483
Annie Tsang NSW 8408



Project No.
12673448

Client	REPOLY PTY LTD
Project	MOSS VALE PLASTICS RECYCLING AND REPROCESSING FACILITY
Status	FOR INFORMATION ONLY

Drawing Title	MULTI-USE BUILDING - ELEVATIONS	Size	A1
Drawing No.	12673448-33	Rev	G

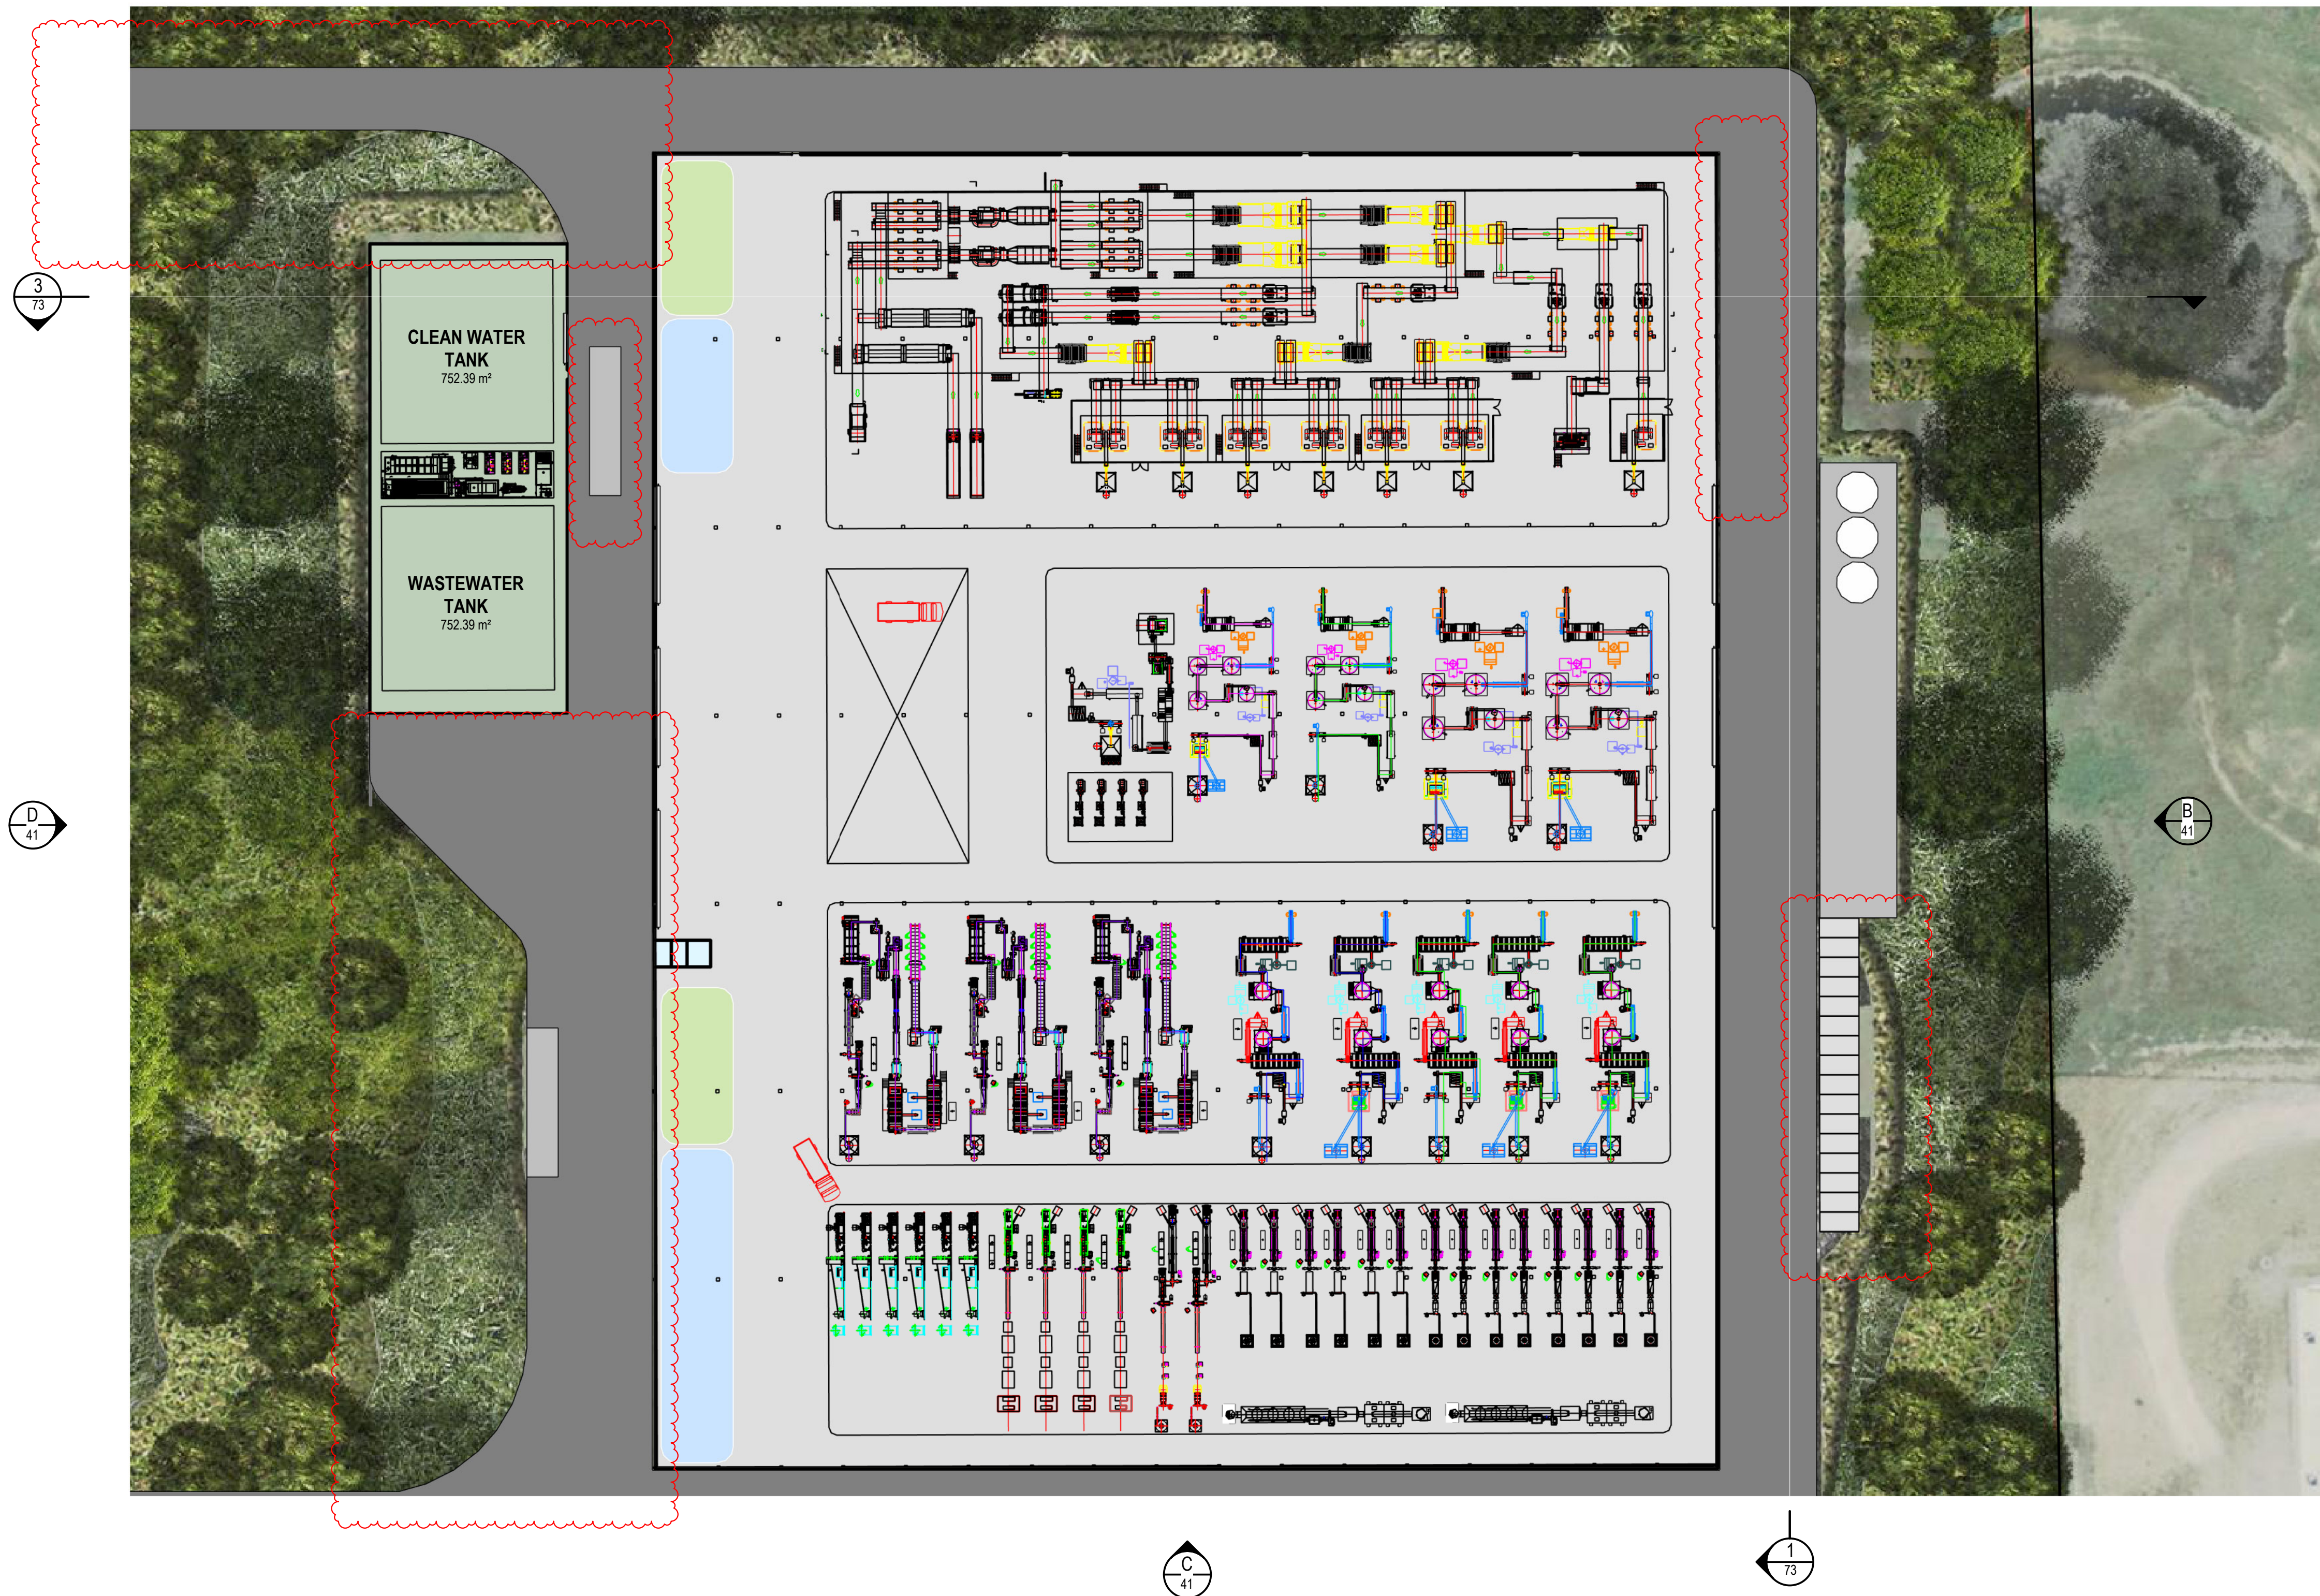

G	ISSUED FOR MOSS VALE APPEAL SUPPORT	L.C.	D.G.	17.07.25
F	ISSUED FOR MOSS VALE APPEAL SUPPORT	L.C.	D.G.	04.07.25
E	ISSUED FOR EIS	L.C.	D.G.	20.04.24
D	ISSUED FOR EIS	L.C.	D.G.	19.04.24
C	ISSUED FOR EIS	L.C.	D.G.	14.03.24
B	ISSUED FOR EIS	L.C.	D.G.	01.02.24
Rev	Description	Checked	Approved	Date
Drafting Check	S.HO	Reg Architect	L.COLLINS	
Design Check	L.COLLINS	State and Reg No.	NSW 11483	

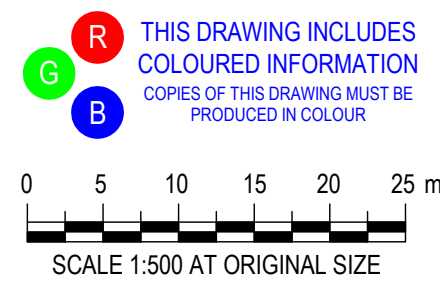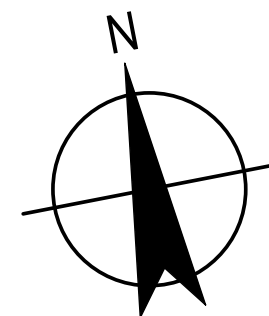

Level 15, 133 Castlereagh Street
Sydney NSW 2000 Australia
T 61 2 9239 7100 F 61 2 9239 7199
E sydney@ghd.com W www.ghd.com/design
Conditions of Use: This document may only be used by GHD Design's client (and any other person who GHD Design has agreed can use this document) for the purpose for which it was prepared and must not be used by any other person or for any other purpose.



Nominated Architects:
Chris Asovski NSW 6843
Daphne Cheong NSW 9410
Lee Collins NSW 11483
Annie Tsang NSW 8408
Project No.
12673448

Client **REPOLY PTY LTD**

Project **MOSS VALE PLASTICS RECYCLING AND REPROCESSING FACILITY**


Status **FOR INFORMATION ONLY**

Drawing Title **BUILDING 1 - MAIN PROCESSING BUILDING - GROUND PLAN**


Drawing No.
12673448-40

Size
A1


Rev
G

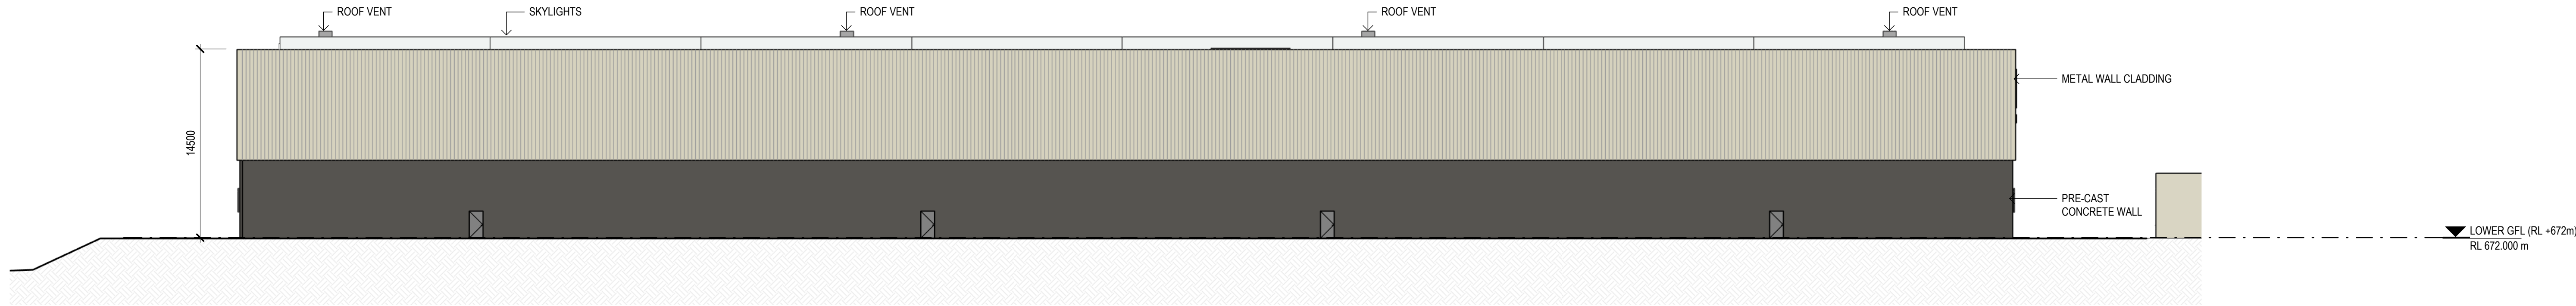


A NORTH ELEVATION
SCALE 1:250

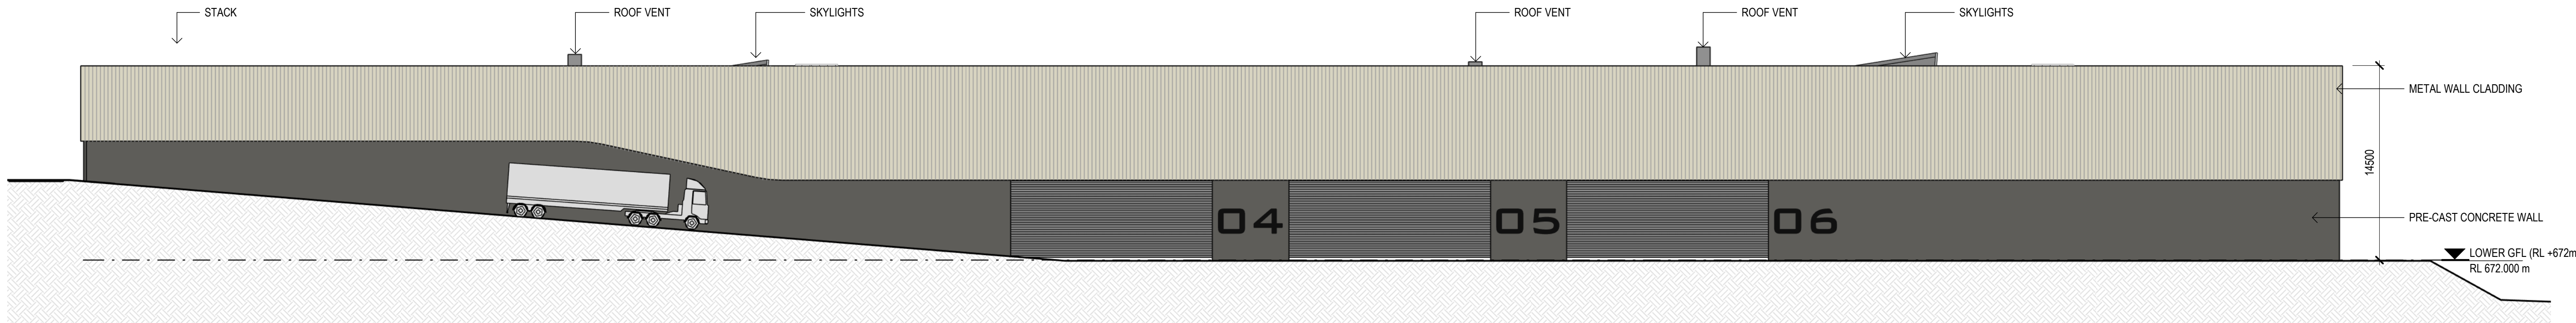

B EAST ELEVATION
SCALE 1:250

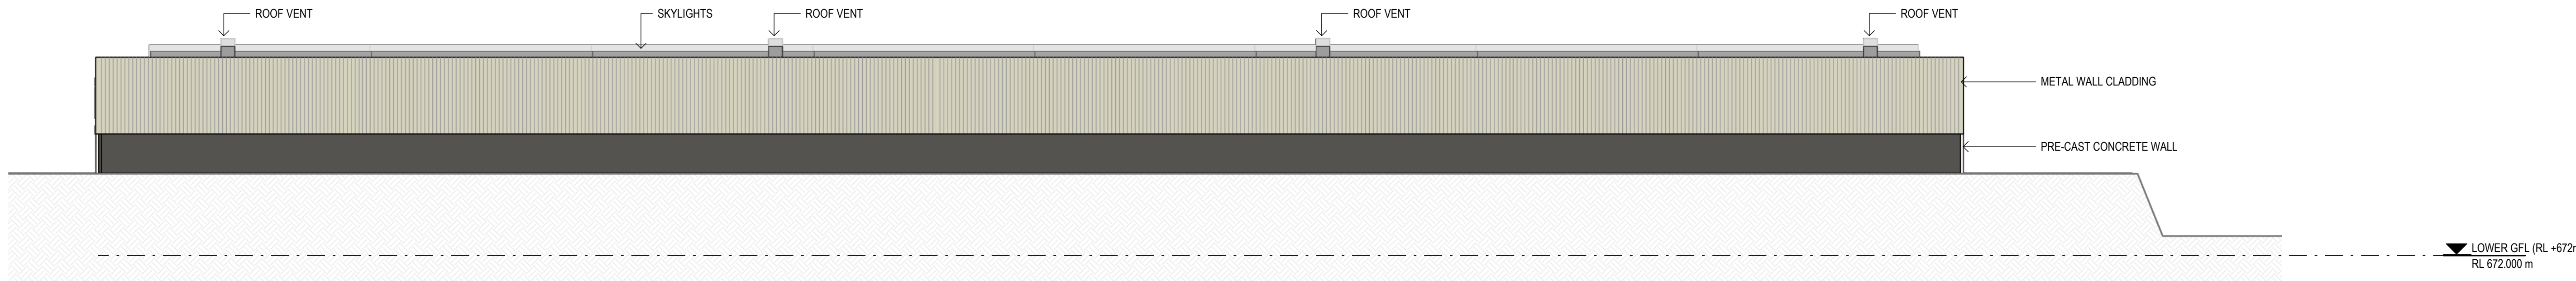


C SOUTH ELEVATION
SCALE 1:250

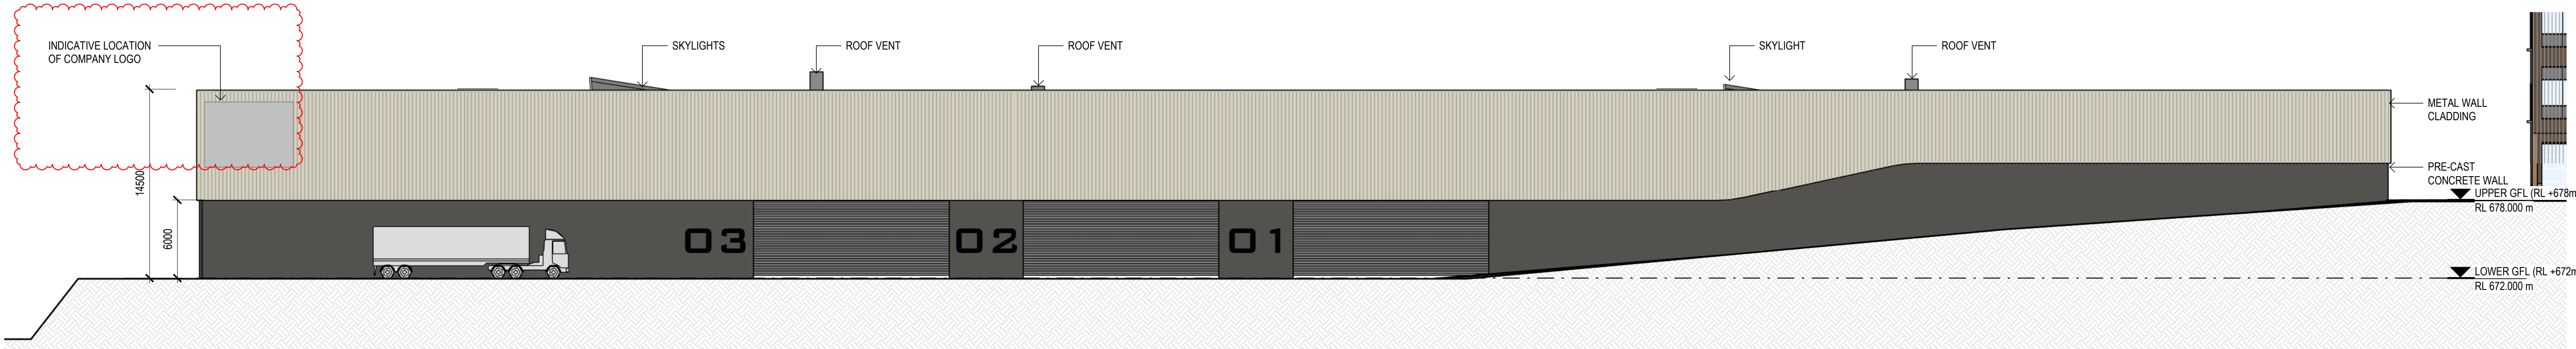

D WEST ELEVATION
SCALE 1:250

G	ISSUED FOR MOSS VALE APPEAL SUPPORT	L.C.	D.G.	17.07.25
F	ISSUED FOR MOSS VALE APPEAL SUPPORT	L.C.	D.G.	04.07.25
E	ISSUED FOR EIS	L.C.	D.G.	20.04.24
D	ISSUED FOR EIS	L.C.	D.G.	19.04.24
C	ISSUED FOR EIS	L.C.	D.G.	14.03.24
B	ISSUED FOR EIS	L.C.	D.G.	01.02.24
Rev	Description	Checked	Approved	Date
Drafting Check	S.HO	Reg Architect	L.COLLINS	
Design Check	L.COLLINS	State and Reg No.	NSW 11483	

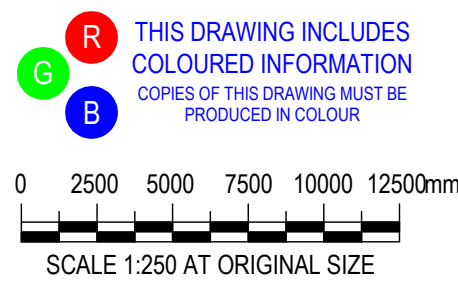

Level 15, 133 Castlereagh Street
Sydney NSW 2000 Australia
T 61 2 9239 7100 F 61 2 9239 7199
E sydmall@ghd.com W www.ghd.com/design
Conditions of Use: This document may only be used by GHD Design's client (and any other person who GHD Design has agreed can use this document) for the purpose for which it was prepared and must not be used by any other person or for any other purpose.



Nominated Architects:
Chris Asovski NSW 6843
Daphne Cheong NSW 9410
Lee Collins NSW 11483
Annie Tsang NSW 8408

Project No.
12673448

Client **REPOLY PTY LTD**

Project **MOSS VALE PLASTICS RECYCLING AND REPROCESSING FACILITY**


Status **FOR INFORMATION ONLY**

Drawing Title **BUILDING 1 - MAIN PROCESSING BUILDING - ELEVATIONS**


Drawing No.
12673448-41

Size **A1**

Rev **G**

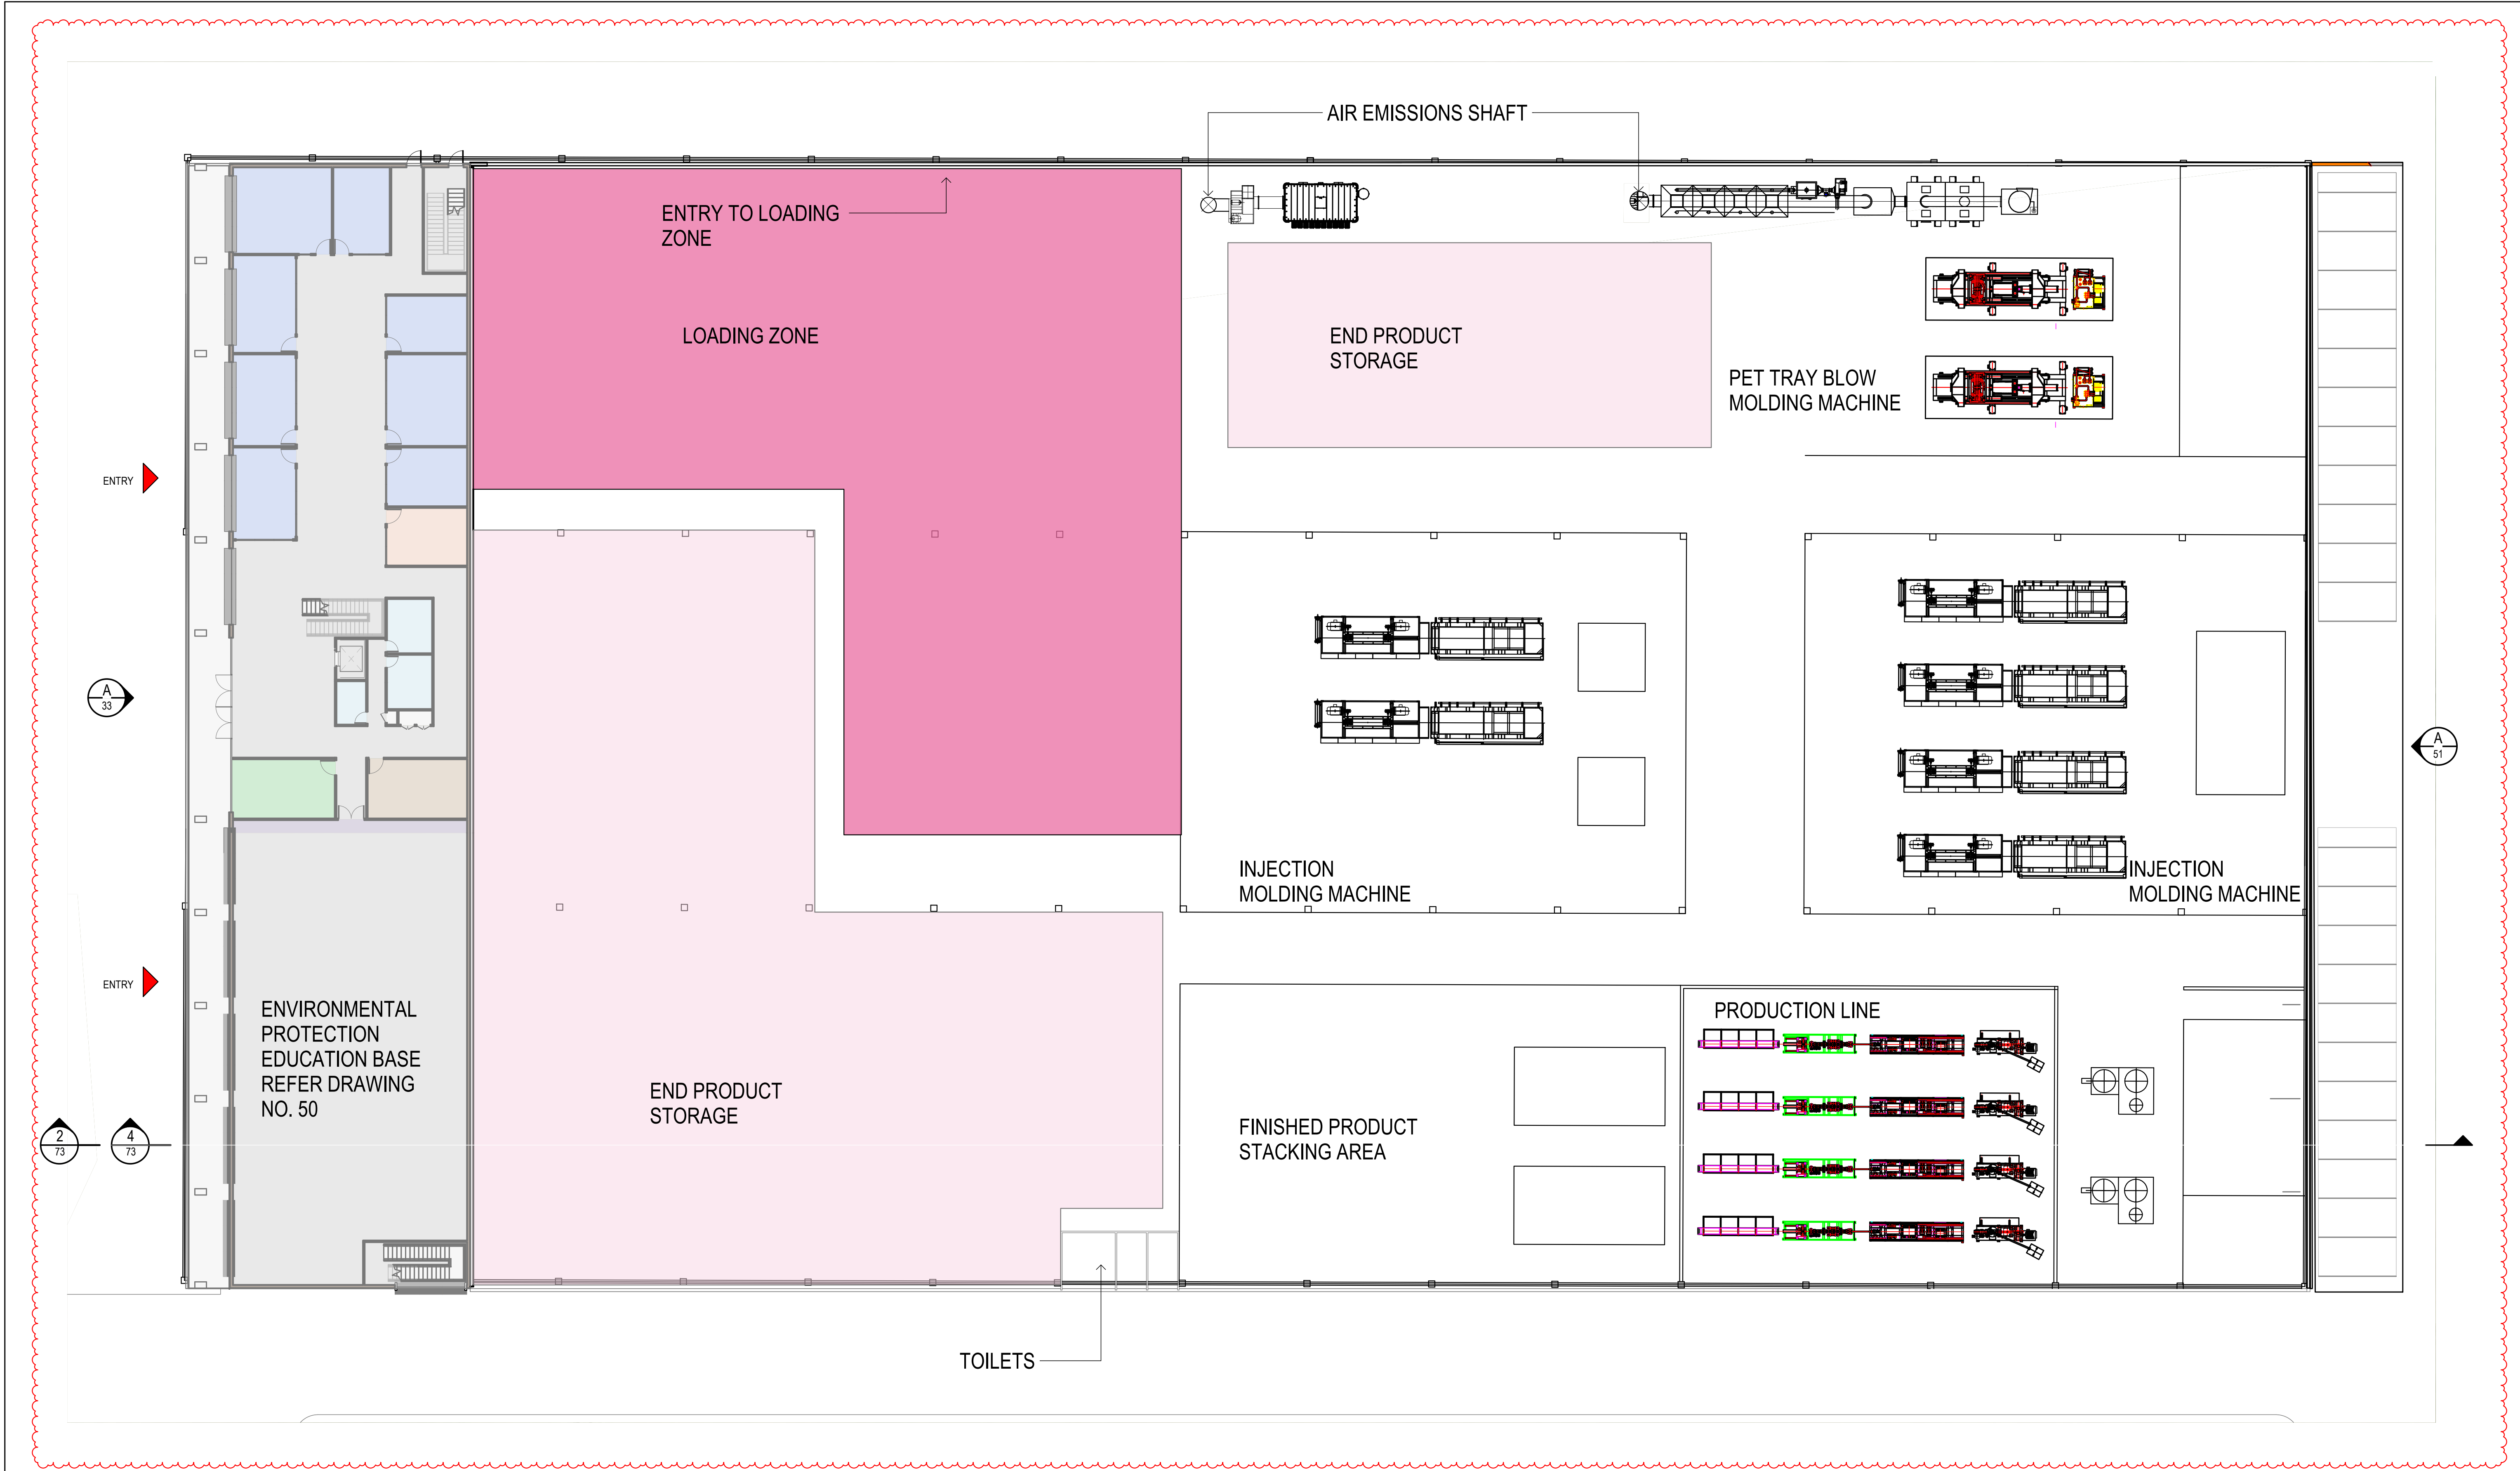

G	ISSUED FOR MOSS VALE APPEAL SUPPORT	LC	D.G	17.07.25
F	ISSUED FOR MOSS VALE APPEAL SUPPORT	LC	D.G	14.07.25
E	ISSUED FOR EIS	LC	D.G	20.04.24
D	ISSUED FOR EIS	LC	D.G	19.04.24
C	ISSUED FOR EIS	LC	D.G	14.03.24
B	ISSUED FOR EIS	LC	D.G	01.02.24
Rev	Description	Checked	Approved	Date
Drafting Check	S.HO	Reg Architect	L.COLLINS	
Design Check	L.COLLINS	State and Reg No.	NSW 11483	

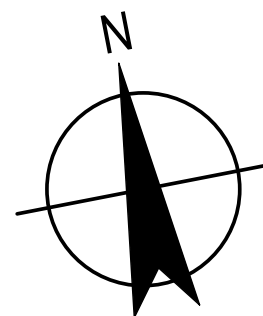

THIS DRAWING INCLUDES
COLOURED INFORMATION
COPIES OF THIS DRAWING MUST BE
PRODUCED IN COLOUR

0 2000 4000 6000 8000 10000mm

SCALE 1:200 AT ORIGINAL SIZE



Level 15, 133 Castlereagh Street
Sydney NSW 2000 Australia
T 61 2 9239 7100 F 61 2 9239 7199
E sydney@ghd.com W www.ghd.com/design
Conditions of Use: This document may only be used by GHD Design's client (and any other person who GHD Design has agreed can use this document) for the purpose for which it was prepared and must not be used by any other person or for any other purpose.



Nominated Architects:
Chris Asovski NSW 6843
Daphne Cheong NSW 9410
Lee Collier NSW 11483
Annie Tsang NSW 8408
Project No.
12673448

Client **REPOLY PTY LTD**


Project **MOSS VALE PLASTICS RECYCLING AND REPROCESSING FACILITY**

Status **FOR INFORMATION ONLY**


Drawing Title **BUILDING 2 - SECONDARY PROCESSING BUILDING - GROUND PLAN**

Drawing No.
12673448-50


Size
A1
Rev
G

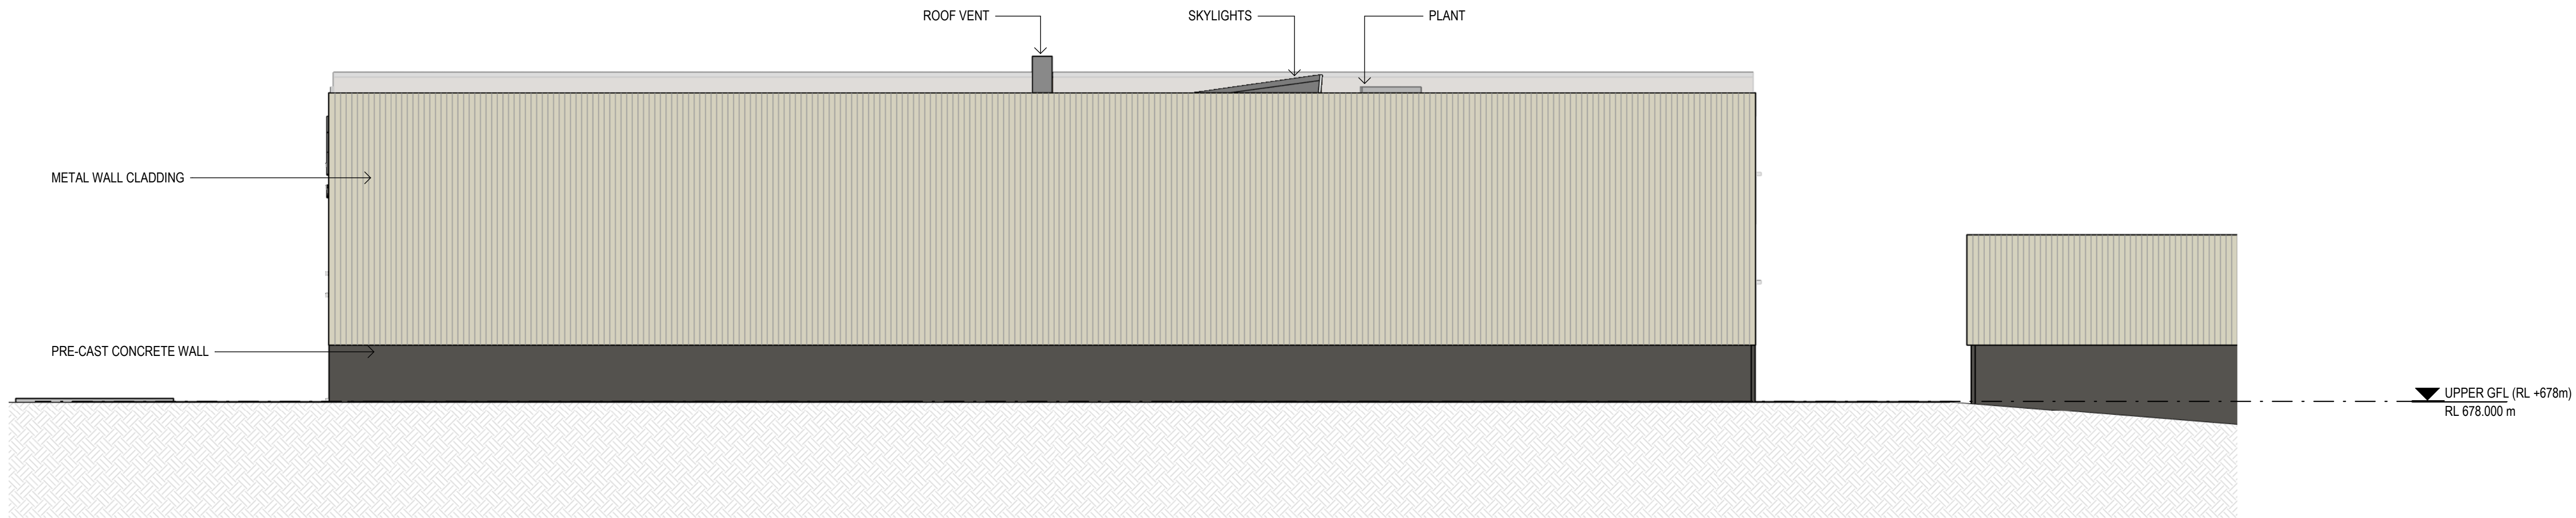

A EAST ELEVATION
SCALE 1:200

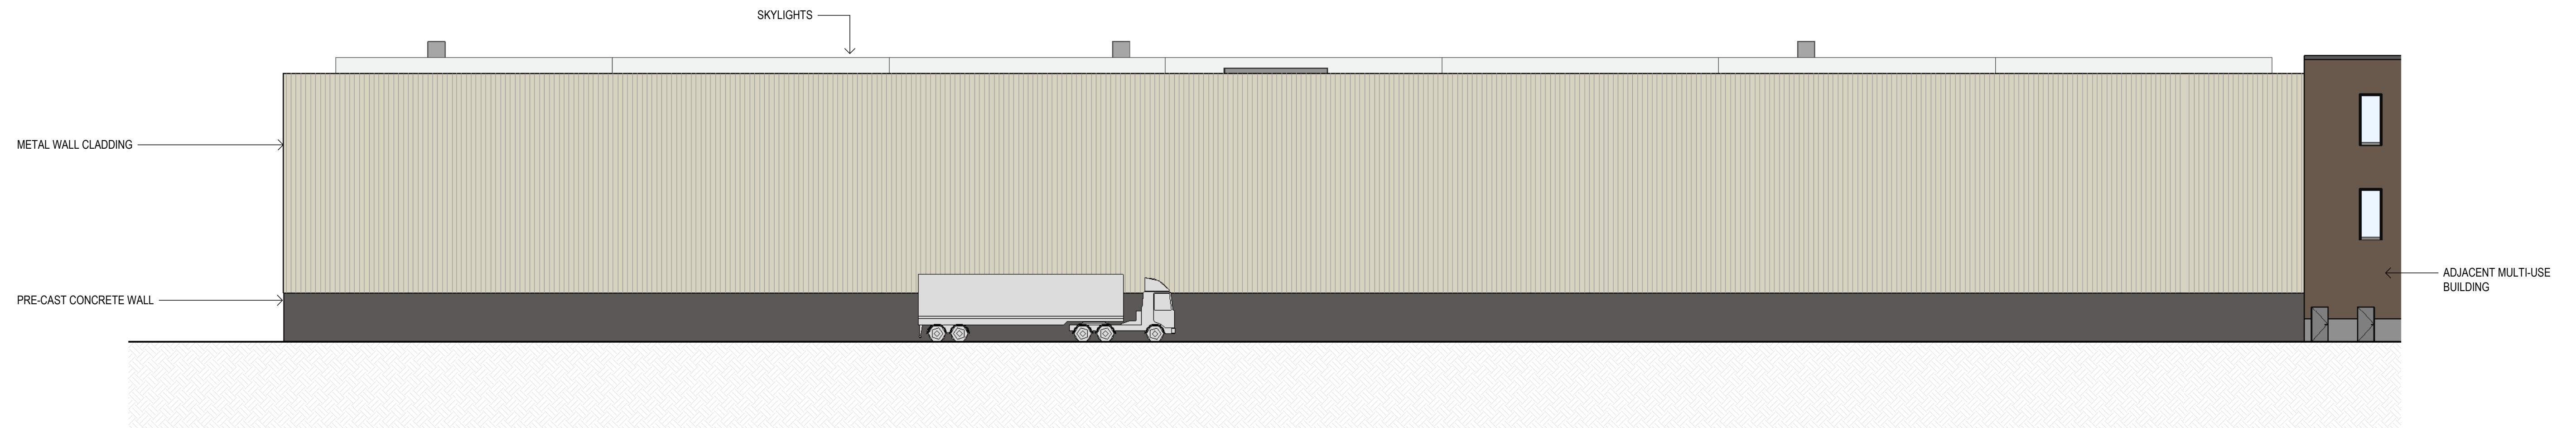


B SECONDARY PROCESSING BUILDING - NORTH ELEVATION
SCALE 1:200

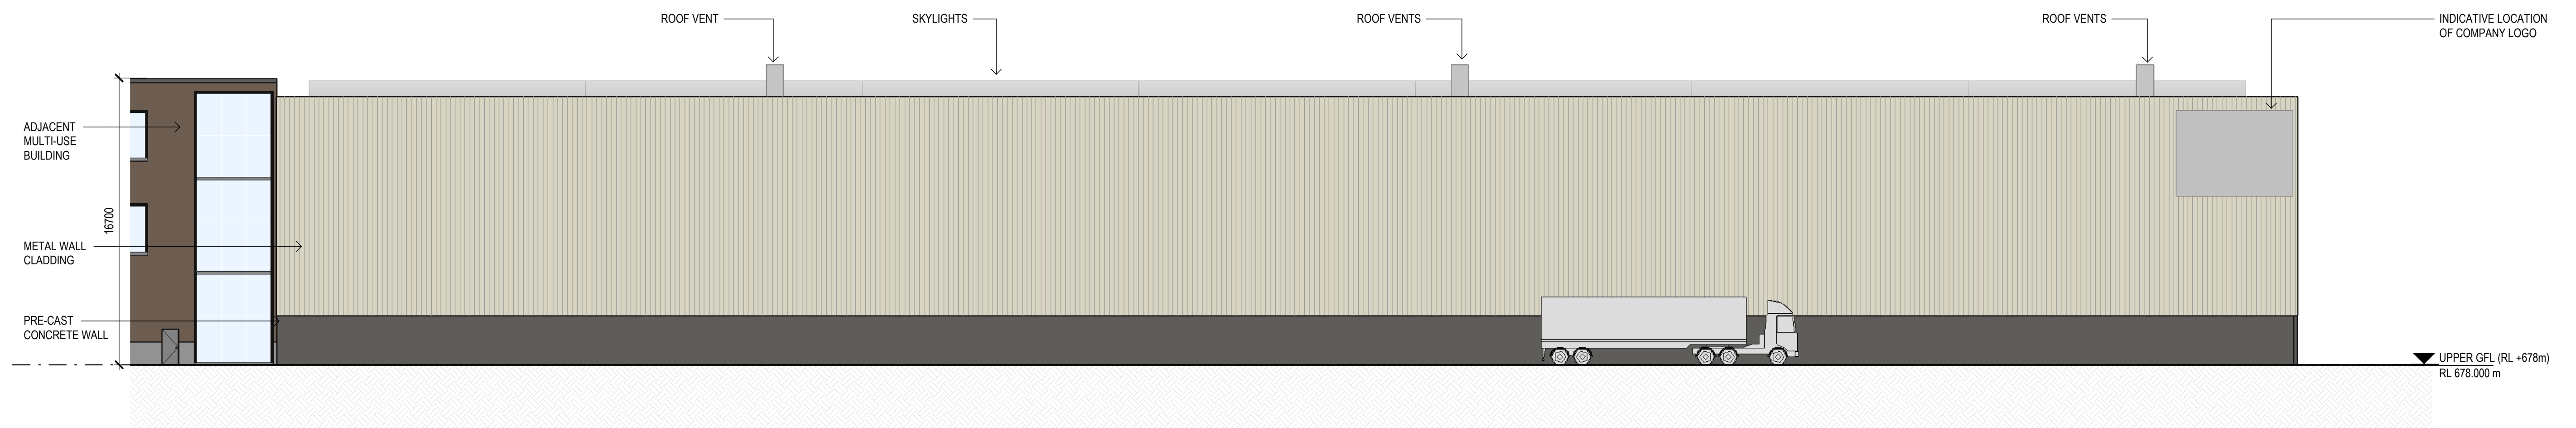

C SECONDARY PROCESSING BUILDING - SOUTH ELEVATION
SCALE 1:200

H	ISSUED FOR MOSS VALE APPEAL SUPPORT	L.C.	D.G.	17.07.25
G	ISSUED FOR MOSS VALE APPEAL SUPPORT	L.C.	D.G.	14.07.25
F	ISSUED FOR MOSS VALE APPEAL SUPPORT	L.C.	D.G.	04.07.25
E	ISSUED FOR EIS	L.C.	D.G.	20.04.24
D	ISSUED FOR EIS	L.C.	D.G.	19.04.24
C	ISSUED FOR EIS	L.C.	D.G.	14.03.24
Rev	Description	Checked	Approved	Date
Drafting Check	S.HO	Reg Architect	L.COLLINS	
Design Check	L.COLLINS	State and Reg No.	NSW 11483	

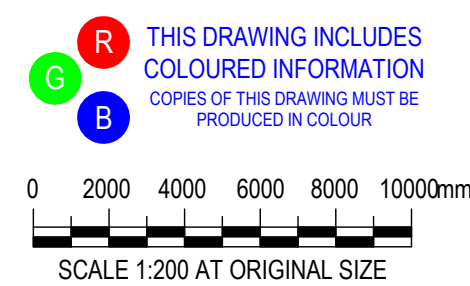

Level 15, 133 Castlereagh Street
Sydney NSW 2000 Australia
T 61 2 9239 7100 F 61 2 9239 7199
E sydney@ghd.com W www.ghd.com/design
Conditions of Use: This document may only be used by GHD Design's client (and any other person who GHD Design has agreed can use this document) for the purpose for which it was prepared and must not be used by any other person or for any other purpose.



Nominated Architects:
Chris Asovski NSW 6843
Daphne Cheong NSW 9410
Lae Collins NSW 11483
Annie Tsang NSW 8408

Project No.
12673448

Client **REPOLY PTY LTD**

Project **MOSS VALE PLASTICS RECYCLING AND REPROCESSING FACILITY**

Status **FOR INFORMATION ONLY**

Drawing Title **BUILDING 2 - SECONDARY PROCESSING BUILDING - ELEVATIONS**


Drawing No.
12673448-51

Size
A1

Rev
H



G	ISSUED FOR MOSS VALE APPEAL SUPPORT	LC	D.G	17.07.25
F	ISSUED FOR MOSS VALE APPEAL SUPPORT	LC	D.G	04.07.25
E	ISSUED FOR EIS	LC	D.G	20.04.24
D	ISSUED FOR EIS	LC	D.G	19.04.24
C	ISSUED FOR EIS	LC	D.G	14.03.24
B	ISSUED FOR EIS	LC	D.G	01.02.24
Rev	Description	Checked	Approved	Date
Drafting Check	S.HO	Reg Architect	L.COLLINS	
Design Check	L.COLLINS	State and Reg No.	NSW 11483	

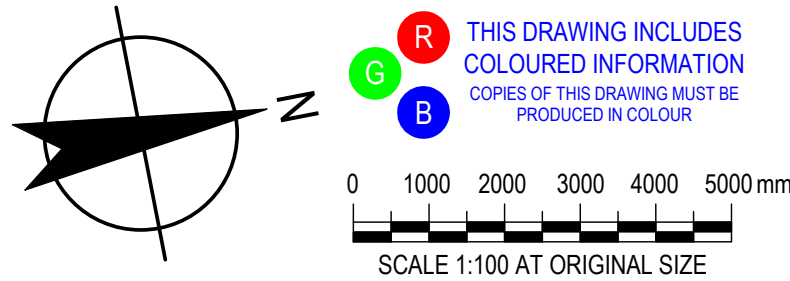

Level 15, 133 Castlereagh Street
Sydney NSW 2000 Australia
T 61 2 9239 7100 F 61 2 9239 7199
E sydney@ghd.com W www.ghd.com/design
Conditions of Use: This document may only be used by GHD Design's client (and any other person who GHD Design has agreed can use this document) for the purpose for which it was prepared and must not be used by any other person or for any other purpose.



Nominated Architects:
Chris Asovski NSW 6843
Daphne Cheong NSW 9410
Lee Collins NSW 11483
Annie Tsang NSW 8408

Project No.
12673448


Client	REPOLY PTY LTD
Project	MOSS VALE PLASTICS RECYCLING AND REPROCESSING FACILITY
Status	FOR INFORMATION ONLY

Drawing Title
WASTE WATER TREATMENT PLANT - GROUND PLAN


Drawing No.
12673448-60

Size
A1

Rev
G

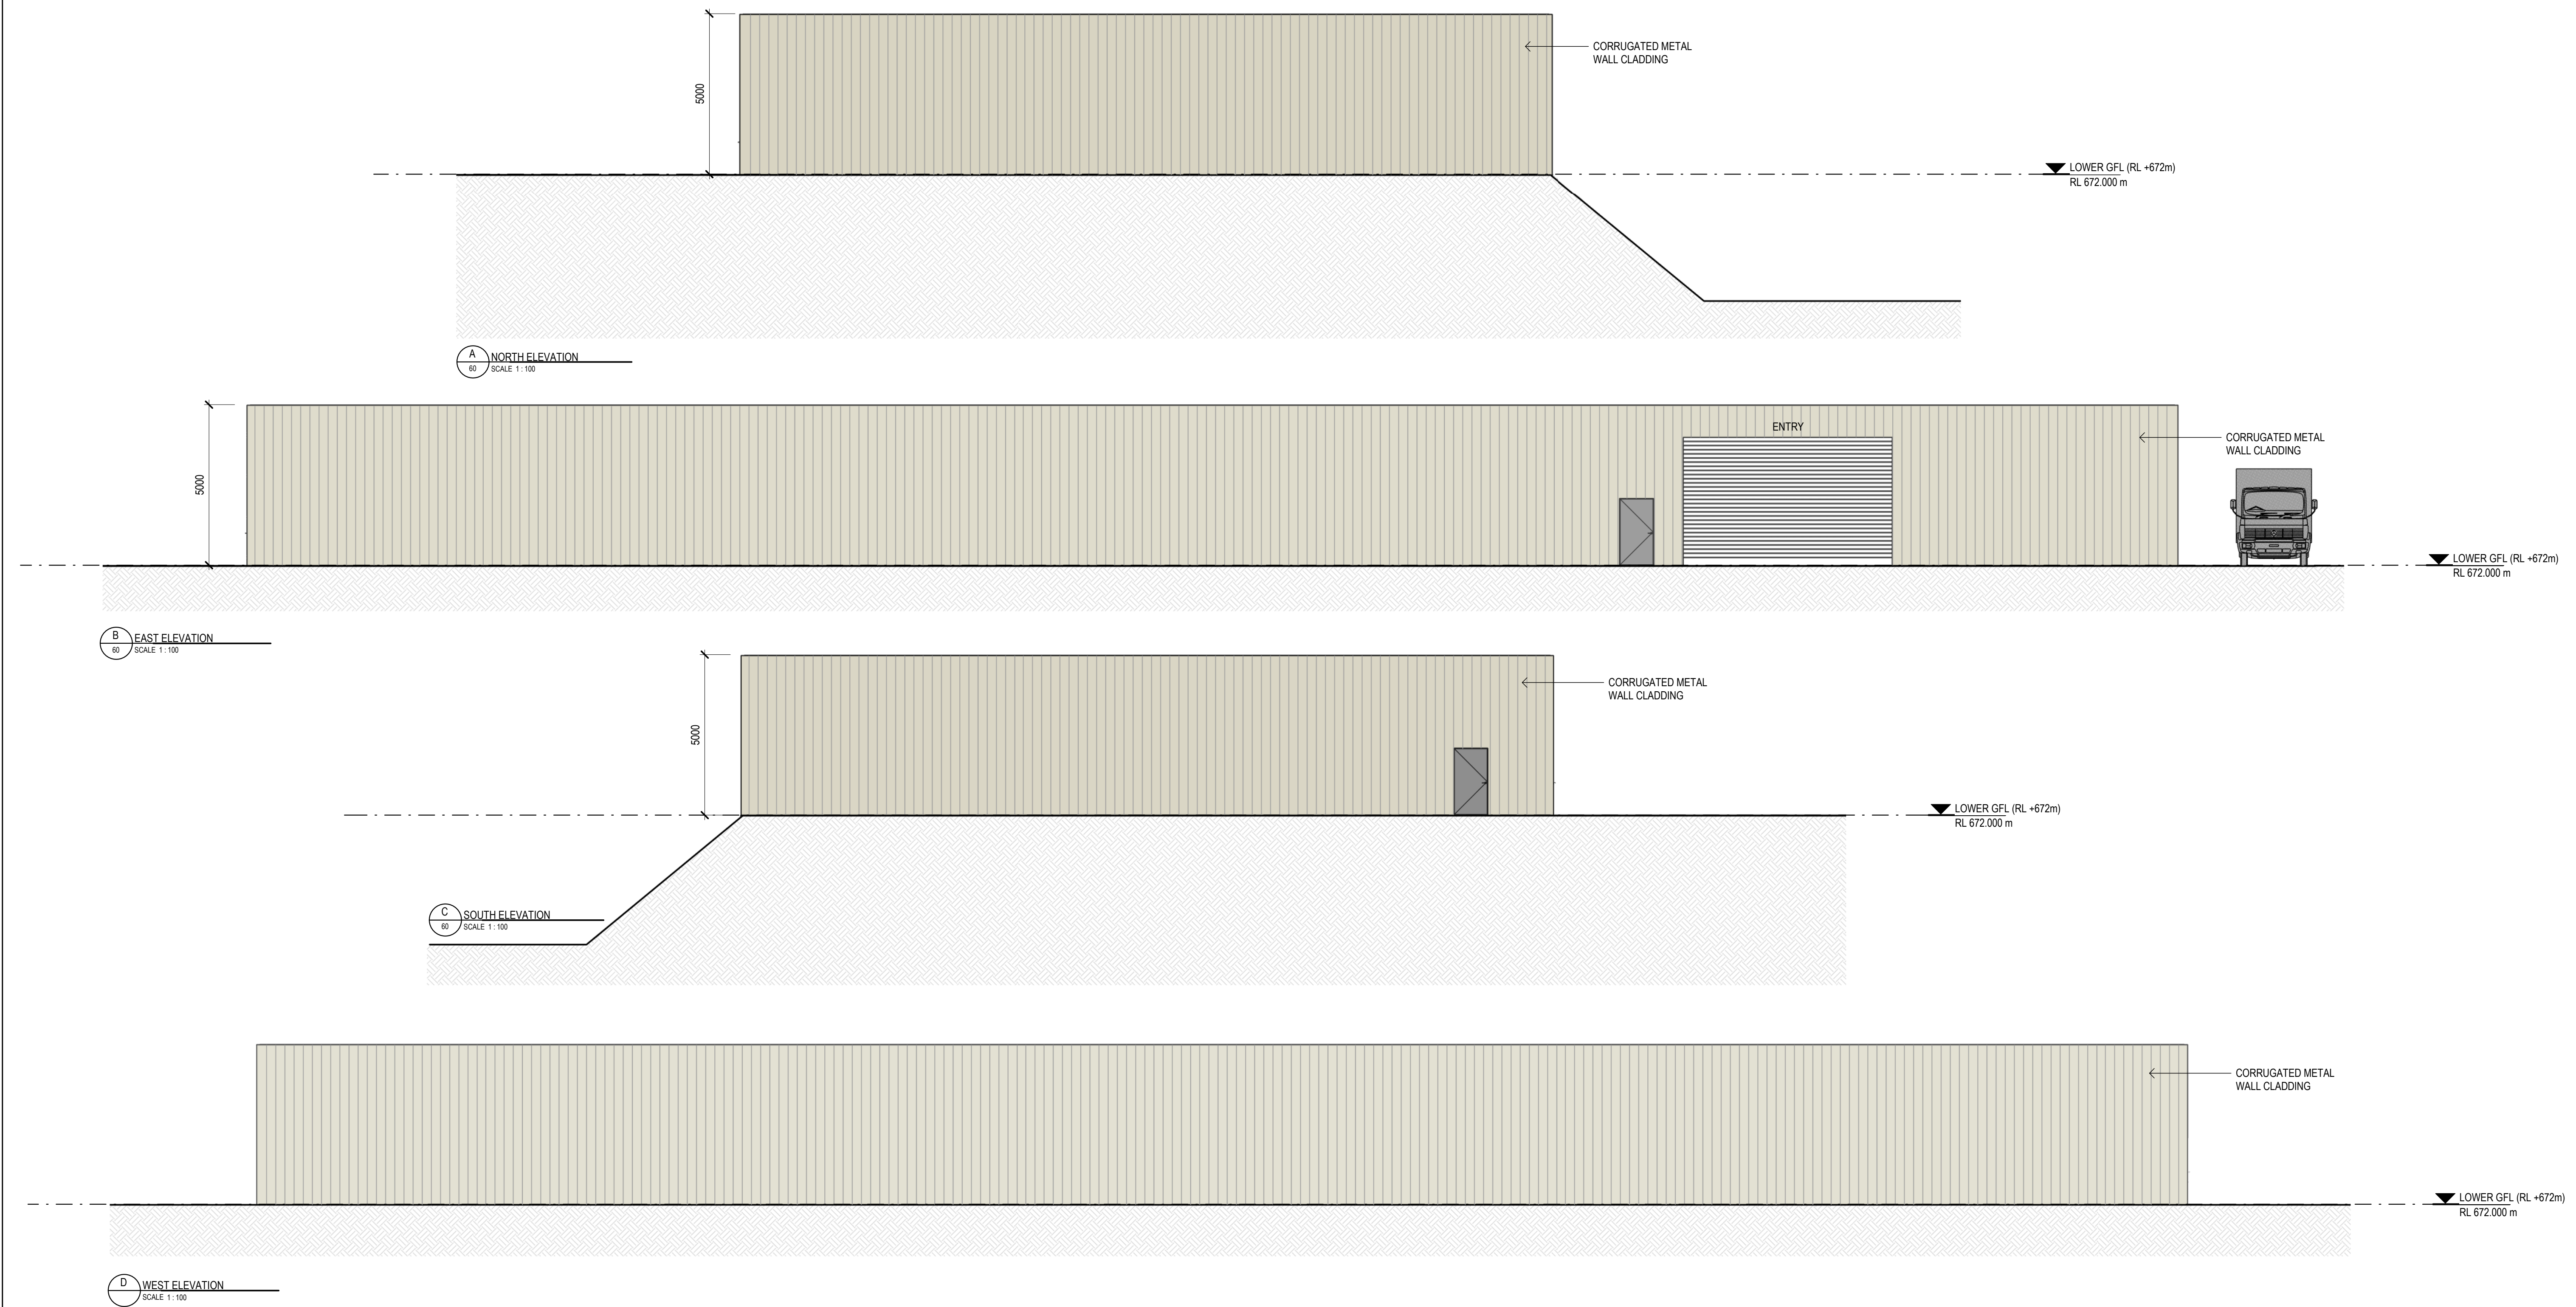

F	ISSUED FOR MOSS VALE APPEAL SUPPORT	L.C.	D.G.	17.07.25
E	ISSUED FOR EIS	L.C.	D.G.	20.04.24
D	ISSUED FOR EIS	L.C.	D.G.	19.04.24
C	ISSUED FOR EIS	L.C.	D.G.	14.03.24
B	ISSUED FOR EIS	L.C.	D.G.	01.02.24
A	ISSUED FOR EIS	L.C.	D.G.	20.12.23
Rev	Description	Checked	Approved	Date
Drafting Check	S.HO	Reg Architect	L.COLLINS	
Design Check	L.COLLINS	State and Reg No.	NSW 11483	

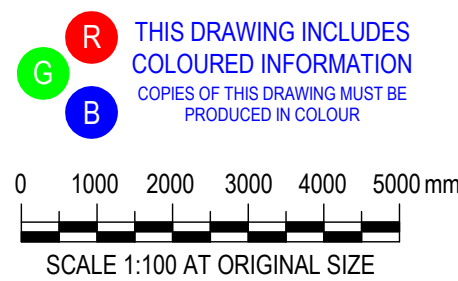

Level 15, 133 Castlereagh Street
Sydney NSW 2000 Australia
T 61 2 9239 7100 F 61 2 9239 7199
E sydney@ghd.com W www.ghd.com/design
Conditions of Use: This document may only be used by GHD Design's client (and any other person who GHD Design has agreed can use this document) for the purpose for which it was prepared and must not be used by any other person or for any other purpose.



Nominated Architects:
Chris Asenovski NSW 6843
Daphne Cheong NSW 9410
Lee Collins NSW 11483
Annie Tsang NSW 8408


Project No.
12673448

Client	REPOLY PTY LTD
Project	MOSS VALE PLASTICS RECYCLING AND REPROCESSING FACILITY
Status	FOR INFORMATION ONLY



Drawing Title
WASTE WATER TREATMENT PLANT - ELEVATIONS

Drawing No.
12673448-61


Size
A1
Rev
F

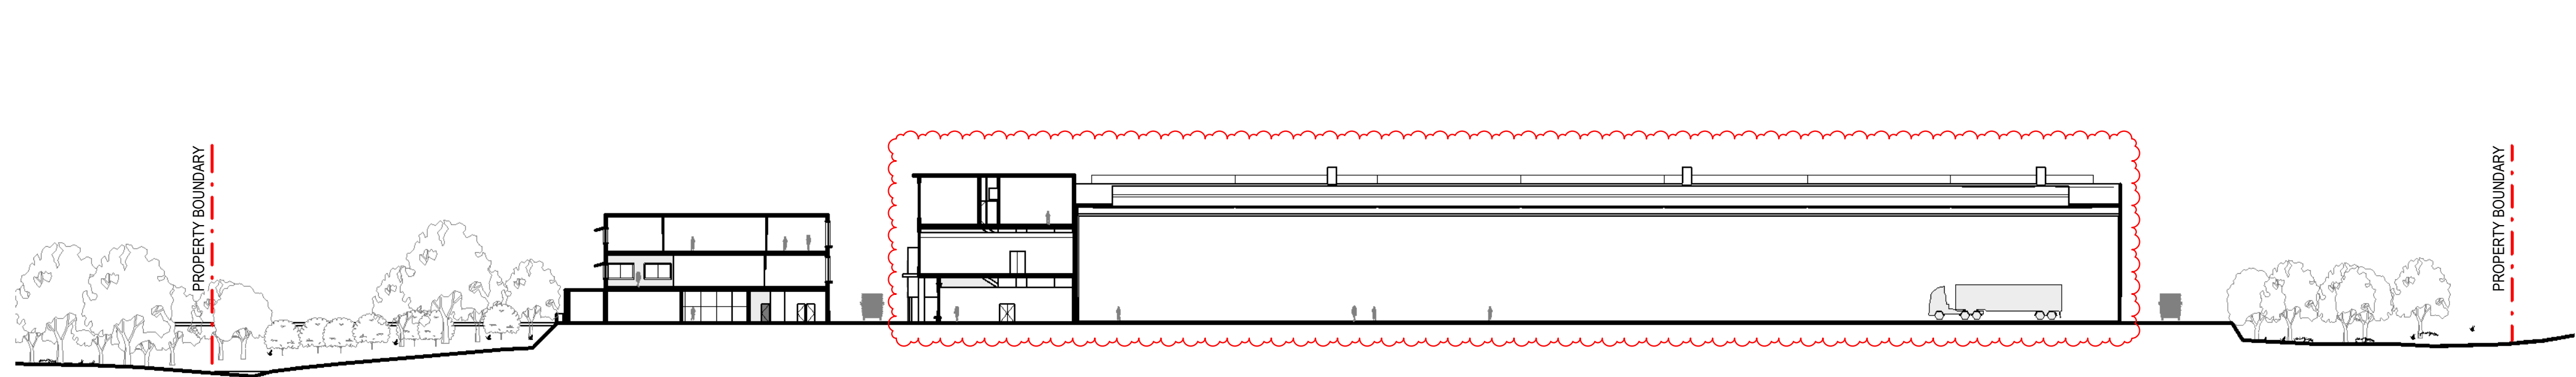


2 SECTION 1
03 SCALE 1:500

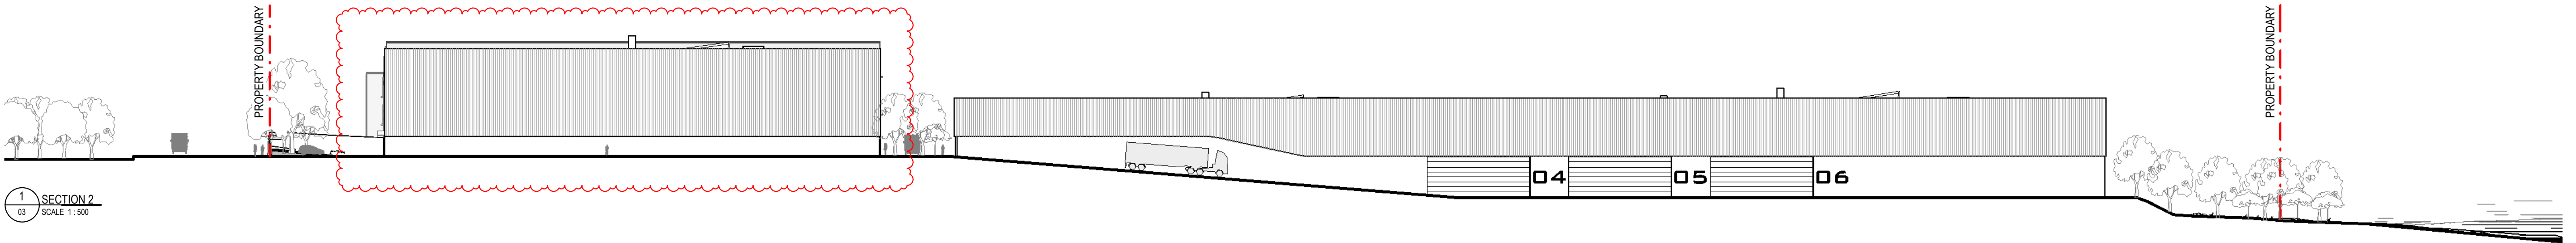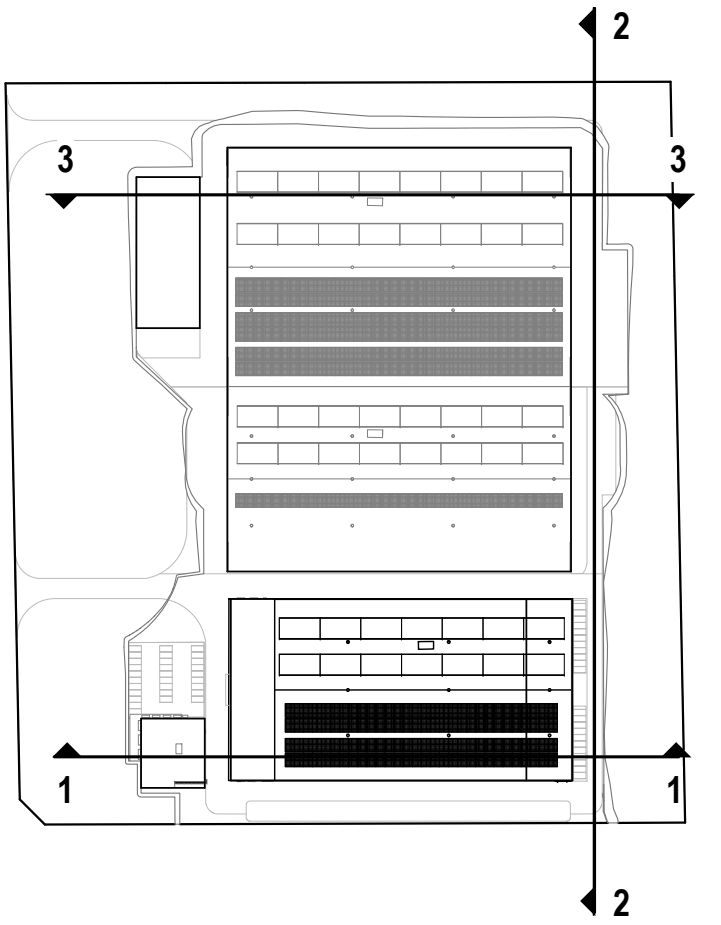

1 SECTION 2
03 SCALE 1:500

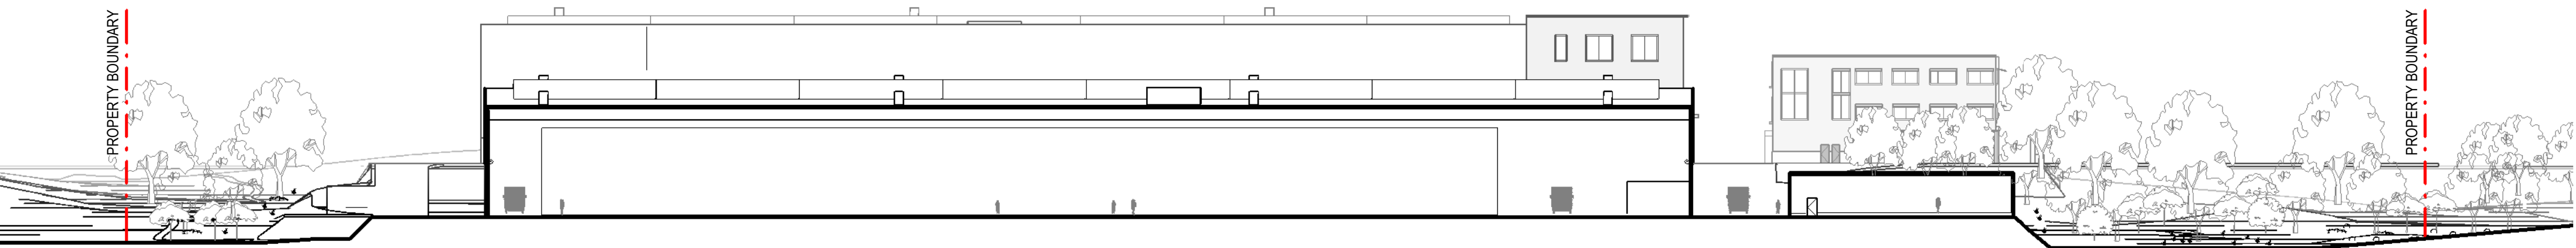


3 SECTION 3
03 SCALE 1:500

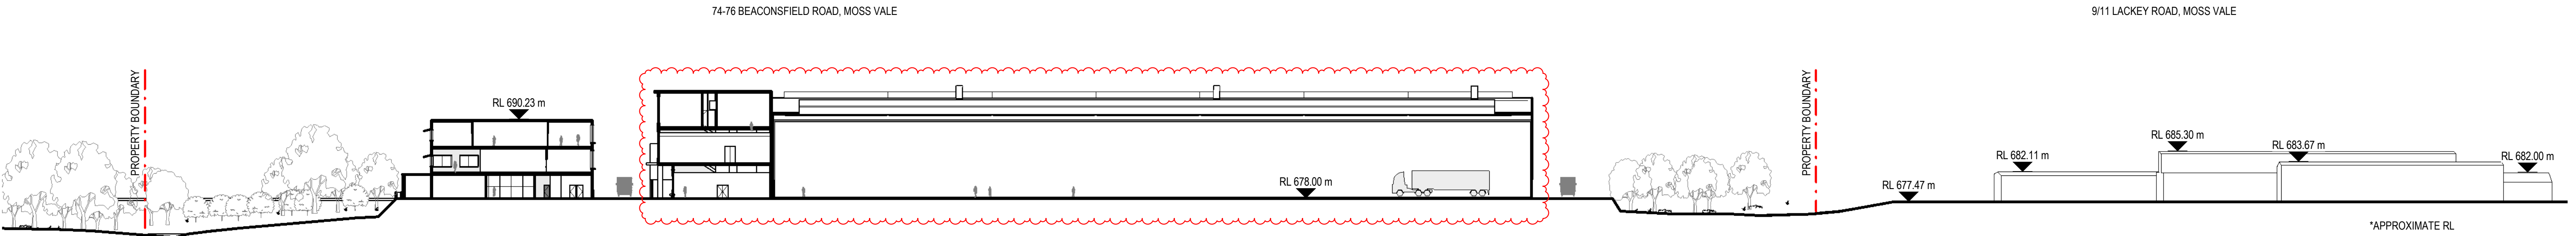

4 SECTION 4 - CONTEXT
03 SCALE 1:500

E	ISSUED FOR MOSS VALE APPEAL SUPPORT	L.C.	D.G.	17.07.25
D	ISSUED FOR MOSS VALE APPEAL SUPPORT	L.C.	D.G.	14.07.25
C	ISSUED FOR MOSS VALE APPEAL SUPPORT	L.C.	D.G.	04.07.25
B	ISSUED FOR EIS	L.C.	D.G.	20.04.24
A	ISSUED FOR EIS	L.C.	D.G.	19.04.24
Rev	Description	Checked	Approved	Date
Drafting Check S.HO		Reg Architect L.COLLINS		
Design Check L.COLLINS		State and Reg No. NSW 11483		

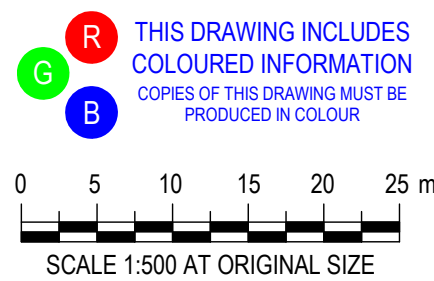

Level 15, 133 Castlereagh Street
Sydney NSW 2000 Australia
T 61 2 9239 7100 F 61 2 9239 7199
E sydney@ghd.com W www.ghd.com/design
Conditions of Use: This document may only be used by GHD Design's client (and any other person who GHD Design has agreed can use this document) for the purpose for which it was prepared and must not be used by any other person or for any other purpose.



Nominated Architects:
Chris Asovski NSW 6843
Daphne Cheong NSW 9410
Lee Collins NSW 11483
Annie Tsang NSW 8408

Project No.
12673448

Client	REPOLY PTY LTD
Project	MOSS VALE PLASTICS RECYCLING AND REPROCESSING FACILITY
Status	FOR INFORMATION ONLY

Drawing Title	SITE SECTIONS
Drawing No.	12673448-73

Size
A1
Rev
E